

LAND CORNER RECORDATION CERTIFICATE

FILING REQUIREMENT OF ACT 74, MICH. P.A.1970
Luce Co. 3 Corners.

FOR CORNERS OF--:	LOCATED IN--:	CORNER CODE NUMBER
1. PUBLIC LAND SURVEY _____	T. _____ N. _____ S., R. _____ E. _____ W. _____	_____
2. PROPERTY CONTROLLING IN SECTION <u>7</u>	T. <u>49</u> N. _____ S., R. <u>12</u> E. _____ W. _____	<u>13-Sec.7</u> <u>14-Sec.7</u> <u>9-Sec.7</u>
3. MISCELLANEOUS PROPERTY IN SECTION _____	T. _____ N. _____ S., R. _____ E. _____ W. _____	_____
4. LOT NO. _____, RECORDED PLAT _____		
5. PRIVATE CLAIMS _____		

REGISTER OF DEEDS STAMP AND FILING NUMBER

I, Billy D. Buckler, do hereby certify that under requirements of P.A. 74, Michigan P.A. of 1970, the corner points mentioned in lines 1 and 2 above were, in a field survey on 5/4-5/, 1977, established, re-established, monumented, re-monumented, recovered or restored as expressed below and in conformance with regulations and rules therefore as required in the current manual of survey instructions of the United States Department of the Interior, Bureau of Land Management or by a decree of a court of law. Furthermore, that the corner points mentioned in lines 3, 4 and 5 above were, in a field survey on _____, 19____, found, recovered, restored, established or re-established as expressed below and in conformance with the rules of the Michigan State Board of Registration for Land Surveyors or, by a Decree of a Court of law:

A. Description of original monument and accessories and/or subsequent restoration:

13-Sec.7 South East 1/16 Corner, Section 7, T49N R12W.

14-Sec.7 South 1/16 on Eastside of Section 7, T49N R12W.

9-Sec.7 East 1/16 Corner of Section 7.

B. Description of corner evidence found and/or method applied in restoring or re-establishing corner:

13-Sec.7 Established Corner at center of South-East quarter section.

14-Sec.7 Established corner midway and on line between section corner to South and $\frac{1}{4}$ corner to North.

9-Sec.7 Established corner midway between Center of section and the East $\frac{1}{4}$ corner.

C. Description of monument for corner and accessories established to perpetuate locating the position of the corner:


Placed 1" pipe with 4" aluminium cap at all corners.

13-Sec.7 New Bearings: 14-Sec.7 Bearings: 9-Sec.7 Bearings:

5" H. Maple, N68°E, 15.0' 14" Cedar S27°E, 10.1' 12" W. Birch, S26°E, 17.6'
 7" H. Maple, S17°E, 16.2' 13" Cedar N80°W, 13.1' 6" W. Birch, N51°E, 11.2'

SIGNED BY Billy D. Buckler
 Billy D. Buckler

DATE 10/5/77

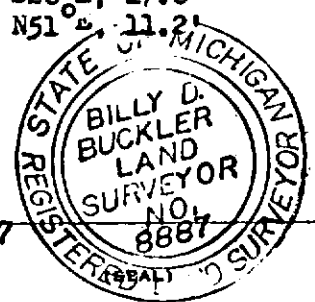

FOR STATE AND UNITED STATES AGENCIES:

SIGNED BY _____ DATE _____
CHIEF OF SURVEY PARTY

APPROVED AND SIGNED BY _____ DATE _____
MICHIGAN REGISTERED LAND SURVEYOR

(SEAL)

SURVEYOR'S MICHIGAN REGISTRATION NO. _____