

MAR 13 2000

SECTION

LAND CORNER RECORDATION CERTIFICATE
Filing Requirement of Act 74, Mich. P.A. 1970

LUCE COUNTY
REGISTER OF DEEDS

Recorded
Liber 3 Page 915
02-08-2000 13:04:21
Kathy S. Mohr
Kathy S. Mohr, Register
REGISTER OF DEEDS

For corners in

<u>Luce</u> (County)	Located In:	Corner Code #
1. Public Land Survey	T49N R12W	A 2 ✓
	T49N R13W	M 2
	T ___ R ___	_____
	T ___ R ___	_____
2. Property Controlling in Section	S ___ T ___ R ___	_____
	S ___ T ___ R ___	_____
3. Miscellaneous Property in Sec.	S ___ T ___ R ___	_____
	S ___ T ___ R ___	_____
4. Lot No. _____, Recorded Plat _____		
5. Private Claims _____		

Register of Deeds Stamp & File Number

	A	B	C	D	E	F	G	H	I	J	K	L	P
1													
2	6		5		4		3		2		1		
3													
4	7		8		9		10		11		12		
5													
6	18		17		16		15		14		13		
7													
8	19		20		21		22		23		24		
9													
10	30		29		28		27		26		25		
11													
12	31		32		33		34		35		36		
13													

I, Robert L. Jamros, in a field survey on March 11, 1996 do hereby state that under requirements of P.A. 74, Michigan P.A. of 1970, the corner points mentioned in lines 1 and 2 above were in conformance with regulations and rules therefore as required in the current manual of survey instructions of the United States Department of the Interior, Bureau of Land Management or by a decree of a Court of Law and for that the corner points mentioned in lines 3, 4 and 5 above were in conformance with the rules of the Michigan Board of Land Surveyors or by a Decree of a Court of Law, established, re-established, monumented, recovered, found as expressed below:

NOTE: Not more than 2 corners, all in the same town and range, may be recorded on this certificate.

A. Description of original monument and accessories and/or subsequent restoration:

A2: P.L.S. - John Burt, DS, 1841, Set qr. section post. ** Cottonwood 2", S.84° E., 29 links; ** Aspen 10", N.14° West, 35 links. **** Michigan Department of Natural Resources, Billy D. Buckler, RLS, 1975. ** Corner re-established on line and by single proportion measure. Found squared post 7.35 feet North and 3.95 feet West of corner position. ** Set 1" iron pipe with 4" aluminum cap. Established the following references. ** W.Pine 10", S.25° W., 22.4 feet; ** R.Pine 14", N. 27° W., 42.7 feet. ** No other subsequent restoration.

B. Description of corner evidence found and/or method applied in restoring or reestablishing corner:


A2: Found 1" G.I.P. with 4" aluminum cap and a 4" flat faced wood post, scribed. ** Also found two existing bearing trees as described in the report of 1975. Existing W.Pine BT in the Southwest position is now a dead stub. Information acquired from the Michigan Department of Natural Resources documenting the method at which the corner position was re-established follows accepted methods. ** Renewed existing bearing tree to current Alger County standards and established additional reference trees. Monument is accepted as a careful and faithful reestablishment of the position of the original corner.

C. Description of monument for corner and accessories established to perpetuate locating the position of the corner:

A2: Stamped P.A. 345 in existing 4" aluminum capped Department of Conservation monument. ** Renewed existing reference tree w/BT signs and paint. ** Established additional reference trees w/BT signs, blazed, scribed and painted. ** Set PK nails for measure w/aluminum I.D. washers in the following reference trees. ** Ex. R.Pine 20", N.21° W., 42.85 feet, "1/4s NBT"; ** R.Pine 8", N.43° E., 50.54 feet, "1/4s BT"; ** R.Pine 15", S.51° E., 54.92 feet, "1/4s BT"; ** R.Pine 7", S.24° W., 25.92 feet, "1/4s BT"; ** Survey marker sign on six foot steel post, S. 68° W., 1.0 feet. ** All bearings are magnetic.



Signed by Robert L. Jamros
Surveyor's Michigan License No. 25849

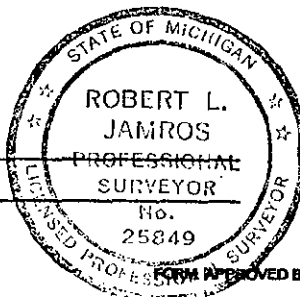

Date June 12, 1996