

SURVEY &  
REMONUMENTATION

MAR 13 2000

SECTION

LAND CORNER RECORDATION CERTIFICATE  
Filing Requirement of Act 74, Mich. P.A. 1970

For comers in

<u>Luce</u> (County)	Located In:	Corner Code #
1. Public Land Survey	T49N R12W T49N R13W	A 3 M 3
2. Property Controlling in Section	S ___ T ___ R ___ S ___ T ___ R ___	___ ___
3. Miscellaneous Property in Sec.	S ___ T ___ R ___ S ___ T ___ R ___	___ ___
4. Lot No. _____, Recorded Plat _____		
5. Private Claims _____		

LUCE COUNTY  
REGISTER OF DEEDS  
Recorded  
*Liber 3 Page 914*  
02-08-2000 13:04:20  
*Kathy S. Mahan*  
Kathy S. Mahan, Register  
REGISTER OF DEEDS

Register of Deeds Stamp & File Number

	A	B	C	D	E	F	G	H	I	J	K	L	M
1													
2	6		5		4		3		2		1		
3													
4	7		8		9		10		11		12		
5													
6	18		17		16		15		14		13		
7													
8	19		20		21		22		23		24		
9													
10	30		29		28		27		26		25		
11													
12	31		32		33		34		35		36		
13													

I, Robert L. Jamros, in a field survey on March 5, 1996 do hereby state that under requirements of P.A. 74, Michigan P.A. of 1970, the corner points mentioned in lines 1 and 2 above were in conformance with regulations and rules therefore as required in the current manual of survey instructions of the United States Department of the Interior, Bureau of Land Management or by a decree of a Court of Law and /or that the corner points mentioned in lines 3, 4 and 5 above were in conformance with the rules of the Michigan Board of Land Surveyors or by a Decree of a Court of Law, established, re-established, monumented, recovered, found as expressed below:

NOTE: Not more than 2 comers, all in the same town and range, may be recorded on this certificate.

A. Description of original monument and accessories and/or subsequent restoration:


A3: PLS - John Burt, DS, 1841. \*\* Set post corner of Sections 1 & 12. \*\* B. Ash (no size given) S. 65°E., 32 links; \*\* B. Ash 12° N.57° E., 18 links. \*\*\*\*\* CCI Forestry Division Land and Timber Examination Report, T.J. McLaren, 1950, indicates a 2" iron pipe at corner position. \*\* No references were given. \*\*\*\*\* Michigan Department of Conservation, Forestry Division, Billy D. Buckler, RLS, 1953. \*\* Corner pointed out to me by B. McTiver, District Forester in Newberry. Three original BT's still in place, poor condition. \*\* Set 1" pipe with 4" brass cap and established the following reference. \*\* Balsam 10", S.32° W., 22 links; \*\* Balsam 8", N.68°E., 22 links. \*\* No other subsequent restoration.

B. Description of corner evidence found and/or method applied in restoring or reestablishing corner:


A3: Found 1" G.I.P. with 4" brass cap driven in center hole of a 2" iron pipe high above the ground and unstable. \*\* Drove monument and pipe down to stable condition. Found BT's of the report of 1953 dead and down. Also found three other unrecorded BT's from a more recent survey in good condition, blazed and scribed. Established an additional BT and upgraded existing BT's to current Alger County standards. \*\* Monument position is accepted as a careful and faithful perpetuation of the position of the original corner.

C. Description of monument for corner and accessories established to perpetuate locating the position of the corner:

A3: Stamped P.A. 345 in existing 4" brass capped Department of Conservation monument. \*\* Renewed existing reference trees w/BT signs and paint. Established additional reference trees w/BT signs, blazed, scribed and painted. \*\* Set PK nails for measure w/aluminum I.D. washers in the following reference trees. \*\* Ex. Balsam 16", S.82° W., 14.67 feet, "12 BT"; \*\* Ex. Maple 10", N.42° W., 17.42 feet, "1 BT"; \*\* Ex. Balsam 14", N.50° E., 21.46 feet, "6 BT"; \*\* Maple 14", S.45° E., 45.58 feet, "S7 BT". \*\* Survey marker sign on six foot steel post, S.23° W., 0.80 feet. \*\* All bearings are magnetic.

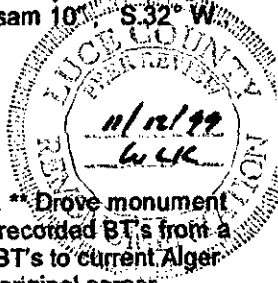

Signed by Robert L. Jamros  
Surveyor's Michigan License No. 25849

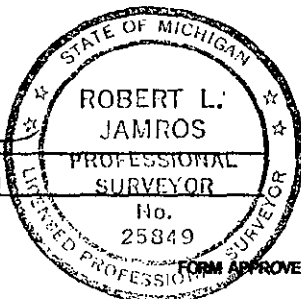

Date June 12, 1996