

MAR 13 2000

SECTION

LAND CORNER RECORDATION CERTIFICATE  
Filing Requirement of Act 74, Mich. P.A. 1970

LUCE COUNTY  
REGISTER OF DEEDS  
Recorded

*Liber 3 Page 910*  
02-08-2000 13:03:44  
*Kathy S. Maha*  
Kathy S. Maha, Register  
REGISTER OF DEEDS

For corners in

<u>Luce</u> (County)	Located in:	Corner Code #
1. Public Land Survey	T49N R12W	A 7 ✓
	T49N R13W	M 7
	T ___ R ___	___
	T ___ R ___	___
2. Property Controlling in Section	S ___ T ___ R ___	___
	S ___ T ___ R ___	___
3. Miscellaneous Property in Sec.	S ___ T ___ R ___	___
	S ___ T ___ R ___	___
4. Lot No. _____, Recorded Plat _____		
5. Private Claims _____		

Register of Deeds Stamp & File Number

	A	B	C	D	E	F	G	H	I	J	K	L	M
1													
2	6		5		4		3		2		1		
3													
4	7		8		9		10		11		12		
5													
6	18		17		16		15		14		13		
7													
8	19		20		21		22		23		24		
9													
10	30		29		28		27		26		25		
11													
12	31		32		33		34		35		36		
13													

I, Robert L. Jamros, in a field survey on June 24, 1998 do hereby state that under requirements of P.A. 74, Michigan P.A. of 1970, the corner points mentioned in lines 1 and 2 above were in conformance with regulations and rules therefore as required in the current manual of survey instructions of the United States Department of the Interior, Bureau of Land Management or by a decree of a Court of Law and /or that the corner points mentioned in lines 3, 4 and 5 above were in conformance with the rules of the Michigan Board of Land Surveyors or by a Decree of a Court of Law; established, re-established, monumented, recovered, found as expressed below:

NOTE: Not more than 2 corners, all in the same town and range, may be recorded on this certificate.

A. Description of original monument and accessories and/or subsequent restoration:


M7: P.L.S. - John Burt, DS, for William A. Burt, DS, 1841. Set post corner of Secs. 13 & 24. Beech 12, S.60°E., 29 links. Beech 11, N.32°W., 36 links. \*\*\*\*\* Billy D. Buckler, RLS, 1960. This corner was replaced as set by Marcus Schaaf, RLS No. 3104. Found 2" pipe in place with wood slabs set at position of bearing trees. Set 1" G.I.P. with 4" brass cap. Witnesses, 17" Hard Maple (S13 NBT), N.11°W., 43 links, 8" Soft Maple (S18 NBT) N.39°E., 38 links, 10" Soft Maple (S19 NBT), S.18°E., 32 1/2 links. \* Liber 2, Page 106, Alger County Corner Records. \*\*\*\*\* C.C.I. Co. Land Corner Records. J.R. Radcliffe, RLS, 1966. Found monument and all BT's of the 1966 report in good condition. No new witnesses were made. \*\*\*\*\* No other record of restoration.

B. Description of corner evidence found and/or method applied in restoring or reestablishing corner:


M7: Located corner position by standard field survey and single proportionate measurements to adjacent corners. Found monument position destroyed and remains of monument. Reference trees have been cut for lumber and all that remains are stumps. Reset corner position from reference tree stumps and installed new monument. Established new reference trees. Corner position as reset and monumentated is accepted as a careful and faithful perpetuation of the position of the original corner.

C. Description of monument for corner and accessories established to perpetuate locating the position of the corner:

M7: Set Bernisen aluminum monument with 3 1/4" aluminum cap no. AINB30, stamped to identify corner position. Established the following reference trees with BT signs, blazed, scribed and painted. Set PK nails for measure with aluminum I.D. washers in the following reference trees. \* Maple 6", N.28°E., 18.53 feet, "S18 BT"; \* Maple 6", S.26°E., 9.34 feet, "S19 BT"; \* Maple 5", S.72°W., 10.48 feet, "S24 BT"; \* Maple 4", N.12°W., 11.08 feet, "S13 BT". Survey marker sign on 6 foot steel post, N.56°W., 0.80 feet. All bearings are magnetic.

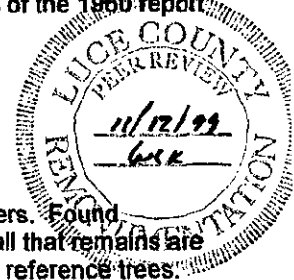

Signed by Robert L. Jamros  
Surveyor's Michigan License No. 25849

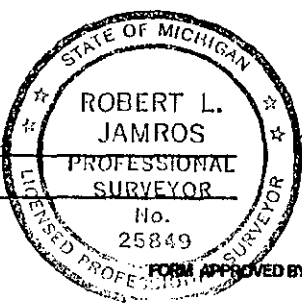

Date December 16, 1998