

LAND CORNER RECORDATION CERTIFICATE
Filing Requirement of Act 74, Mich. P.A. 1970 as Amended

For corners in

Luce	Located In:	Corner Code #
(County)		
1. Public Land Survey	T _____ R _____	_____
	T _____ R _____	_____
	T _____ R _____	_____
2. Property Controlling in Section	S <u>27</u> T <u>49N</u> R <u>12W</u>	<u>12</u>
	S <u>27</u> T <u>49N</u> R <u>12W</u>	<u>6</u>
	S _____ T _____ R _____	_____
3. Miscellaneous Property in Sec.	S _____ T _____ R _____	_____
	S _____ T _____ R _____	_____
4. Lot No. _____, Recorded Plat _____		
5. Private Claims _____		

Register of Deeds Stamp & File Number

	A	B	C	D	E	F	G	H	I	J	K	L	M
1													
2	6		5		4		3		2		1		
3													
4	7		8		9		10		11		12		
5													
6	18		17		16		15		14		13		
7													
8	19		20		21		22		23		24		
9													
10	30		29		28		27		26		25		
11													
12	31		32		33		34		35		36		
13													

I, Stephan J. Szyszkoski, in a field survey on 12 02/16/2010 do hereby state that under requirements of P.A. 74, Michigan P.A. of 1970, the corner points mentioned in lines 1 and 2 above were in conformance with regulations and rules therefore as required in the current manual of survey instructions of the United States Department of the Interior, Bureau of Land Management or by a decree of a Court of Law and /or that the corner points mentioned in lines 3, 4 and 5 above were in conformance with the rules of the Michigan Board of Land Surveyors or by a Decree of a Court of Law; established, re-established, monumented, recovered, found as expressed below:

NOTE: Not more than 2 corners, all in the same town and range, may be recorded on this certificate.

A. Description of original monument and accessories and/or subsequent restoration:

(12-Sec. 27) South 1/16 corner, Section 27. Not established in the original survey.

(6-Sec. 27) Northeast 1/16 corner, Section 27. Not established in the original survey.

B. Description of corner evidence found and/or method applied in restoring or reestablishing corner:

(12-Sec. 27) Established the corner midway and on a straight line between Center of Section 1326.08' north and Quarter corner 1326.08' south.

(6-Sec. 27) Established the corner at the intersection of straight lines connecting opposite 1/16 corners.


C. Description of monument for corner and accessories established to perpetuate locating the position of the corner:

(12) Set 1"IDx36" I.pipe with 4" alum. MDNR cap.
 Set measuring nail with MDNR tag in the side of:
 24" Hemlock S40E 82.0' mrkd "S1/16 BT"
 12" Maple S72W 23.5' do
 14" Maple N03E 46.5' do
 16" Y.Birch N85E 47.2' do
 Bearings are magnetic.

(6) Set 1"IDx36" I.pipe with 4" alum. MDNR cap.
 Set measuring nail with MDNR tag in the side of:
 10" Maple N60W 7.05' mrkd "NE1/16 BT"
 14" Maple S58W 9.4' do
 10" Maple S64E 7.47' do
 12" Maple S30E 17.3' do
 Bearings are magnetic.

Signed by Stephan J. Szyszkoski
 Surveyor's Michigan License No. 33986

Date 04/15/2010

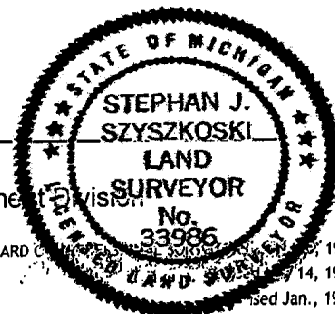

For the Michigan Department of Natural Resources and Environment, Forest Management Division