

MICHIGAN
DEPARTMENT OF CONSERVATION
FORESTRY DIVISION

LAND CORNER RECORD

T. 50N N. R. 8W


Luce COUNTY

DESCRIPTION OF CORNER ¼ Cor. bet. Secs. 11-14

CORNER MONUMENT 1" pipe with 4" aluminum cap

DATE MONUMENT PLACED AND WITNESSED 9-11-70

WITNESSES TO CORNER..... 14" Hard Maple (¼S NBT) N11°E 29.3'

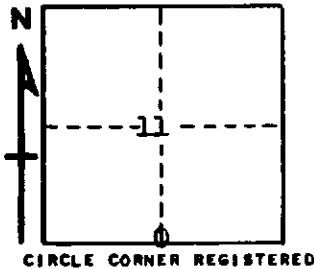

AND

DESCRIPTION IN DETAIL AS TO HOW CORNER WAS LOCATED AND IDENTIFIED OR RESTORED.

This corner replaced at wood post set by unknown surveyor.
Found Hard Maple witness bearing S71°E 41 links. Tree green and in fair condition.
Corner lies 15' east of road.

SURVEYOR'S SEAL

Billy D. Buckler
SIGNED Billy D. Buckler DATE 9-23-70
REGISTERED LAND SURVEYOR