LAND CORNER RECORDATION CERTIFICATE

Filing Requirement of Act 74, Mich. P.A. 1970

For corners in Luce (County)

	Located In:	Corner Code #
1. Public Land Survey	T 50N R 8W	E8
	T ___ R ___	
	T ___ R ___	
	T ___ R ___	
2. Property Controlling	S 21 T 50N R 8W	14
in Section	S ___ T ___ R ___	
3. Miscellaneous	S ___ T ___ R ___	
Property in Sec.	S ___ T ___ R ___	

Register of Deeds Stamp & File Number

4. Lot No. _____ , Recorded Plat _____
5. Private Claims _____

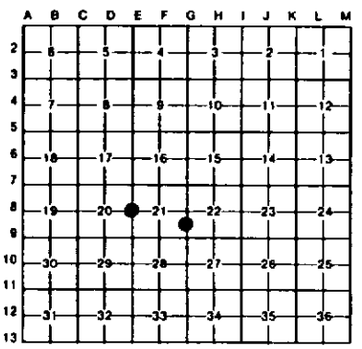

E8 March 01, 1994

I, Stephan J. Szyszkoski, in a field survey on 14 February 24, 1994, 19 _____, do hereby certify that under requirements of P.A. 74, Michigan P.A. of 1970, the corner points mentioned in lines 1 and 2 above were in conformance with regulations and rules therefore as required in the current manual of survey instructions of the United States Department of the Interior, Bureau of Land Management or by a decree of a Court of Law and/or that the corner points mentioned in lines 3, 4 and 5 above were in conformance with the rules of the Michigan Board of Land Surveyors or by a Decree of a Court of Law; established, re-established, monumented, re-monumented, recovered, found as expressed below:

NOTE: Not more than 4 corners, all in the same town and range, may be recorded on this certificate.

A. Description of original monument and accessories and/or subsequent restoration:

(E8) Quarter corner common to Sections 20-21. Corner remonumented in 1952 by Dean C. DeLaNater from one original BT, in good condition. The 1952 record states: Set 1" pipe with 4" Brass cap, 9" W. Pine N40W 44 links, 8" Red Pine S35W 80 links.

(14-Sec.21) South 1/16 corner between Sections 21-22. Corner not established in the original survey. Found no subsequent record.

B. Description of corner evidence found and/or method applied in restoring or reestablishing corner:

(E8) Found and accepted DeLaNater's monument as described, at record bearing and distance from the 1952 NBTs, both in good condition. Placed measuring nails in these NBTs, marked new upper blazes, and also marked two new bearing trees as described below. Corner lies approximately 42' north of a trail road.

(14-Sec.21) Found no evidence of prior monumentation at the corner position. Established the corner midway and on a straight line between Quarter corner 1320.99' North and Section corner 1320.99' South. Monumented the corner position with a 1" I.D.x36" painted iron pipe capped with a 4" dia. cast aluminum MDNR tablet, appropriately stamped.

C. Description of monument for corner and accessories established to perpetuate locating the position of the corner:

(E8) Found 1" pipe with 4" brass cap. Blazed, scribed, and set measuring nails in the following new bearing trees:
10" W. pine S04W 11.95' "1/4S NBT"
10" W. Pine S38E 23.15' "1/4S NBT"
the 1952 bearing trees:
22" W. Pine N40W 29.1' "1/4S NBT"
20" R. Pine S35W 53.4' "1/4S NBT"
Placed a 6" squared cedar post, and the old post adjacent. Bearings are magnetic.

STATE OF MICHIGAN
STEPHAN J. SZYSZKOSKI
LAND SURVEYOR
No. 33986
LICENSED LAND SURVEYOR

(14) Set 1" pipe with 4" MDNR cap. Blazed, scribed, and set measuring nails in the following bearing trees:
12" J. Pine N89W 20.35' "S1/16 BT"
5" Spruce N85W 9.05' "S1/16 BT"
12" J. Pine S84E 17.5' "S1/16S BT"
6" J. Pine S40E 21.7' "S1/16 BT"
Bearings are magnetic.

Signed by Stephan J. Szyszkoski Date 5-10-94

Surveyor's Michigan License No. 33986

FORM APPROVED BY MICHIGAN STATE BOARD OF LAND SURVEYORS, JAN. 28, 1971
REVISED MAY 14, 1975