

**LAND CORNER RECORDATION CERTIFICATE**  
**Filing Requirement of Act 74, Mich. P.A. 1970 as Amended**

For corners in

Luce	Located In:	Corner Code #
<small>(County)</small>		
1. Public Land Survey	T 50N R 8W	D11
	T 50N R 8W	E12
	T _____ R _____	_____
2. Property Controlling in Section	S _____ T _____ R _____	_____
	S _____ T _____ R _____	_____
3. Miscellaneous Property in Sec.	S _____ T _____ R _____	_____
	S _____ T _____ R _____	_____

Register of Deeds Stamp & File Number

4. Lot No. \_\_\_\_\_, Recorded Plat \_\_\_\_\_  
 5. Private Claims

E12 Aug 04 2005  
 D11 Aug 11 2005

A	B	C	D	E	F	G	H	I	J	K	L	M
1												
2	6	5	4	3	2	1						
3												
4	7	8	9	10	11	12						
5												
6	18	17	16	15	14	13						
7												
8	19	20	21	22	23	24						
9												
10	30	29	28	27	26	25						
11		●										
12	31	32	●	33	34	35	36					
13												

I, Stephan J. Szyszkoski, in a field survey on \_\_\_\_\_, 20\_\_\_\_ do hereby state that under requirements of P.A. 74, Michigan P.A. of 1970, the corner points mentioned in lines 1 and 2 above were in conformance with regulations and rules therefore as required in the current manual of survey instructions of the United States Department of the Interior, Bureau of Land Management or by a decree of a Court of Law and /or that the corner points mentioned in lines 3, 4 and 5 above were in conformance with the rules of the Michigan Board of Land Surveyors or by a Decree of a Court of Law; established, re-established, monumented, recovered, found as expressed below:

**NOTE: Not more than 2 corners, all in the same town and range, may be recorded on this certificate.**

**A. Description of original monument and accessories and/or subsequent restoration:**


(D11) Quarter corner common to Sections 29 and 32. 1971 - Corner remonumented from one original witness tree by Billy D. Buckler RLS. Set 1" pipe with 4" aluminum cap. New witnesses: 14" R.Pine S89E 9.3', 14" R.Pine S52W 34.9'.  
 (E12) Quarter corner common to Sections 32-33. 1958 - Remonumented by Billy D. Buckler RLS: Replaced as set by Marcus Schaff, Reg. Surveyor. Iron pipe in place. White Pine BT bearing S48W 12 links in fair condition. (stub) Squared and scribed 5" W.Birch at corner. Set 1" pipe with 4" brass cap. 16" Red Pine N36E 16 links, 13" White Pine S11E 20 links.

**B. Description of corner evidence found and/or method applied in restoring or reestablishing corner:**

(D11) Found the 1971 monument in good condition and at record bearing and distance from the 1971 NBTs, both in good condition. Also recovered the original W.Pine BT N37W 42 links, a 24" stub with axe marks still evident, at record bearing and distance. Left the monument in place and made new witnesses as described below. The corner lies 45' north of an old 4x4 trail.  
 (E12) Recovered the 1958 monument in good condition and at record bearing and distance from the 1958 NBTs, both in good condition with overgrown blazes. The 5" W.Birch adjacent to the corner is now a stump. The W.Pine BT noted in the 1958 record was not recovered. Left the monument in place and made new witnesses as described below.

**C. Description of monument for corner and accessories established to perpetuate locating the position of the corner:**

(D11) Found 1" I.pipe with 4" alum. MDNR cap. Set measuring nails in:	(E12) Found 1" ID I.pipe with 4" brass MI Dept of Conservation cap. Set measuring nails in:
18" R. Pine S81E 9.65' old marks *	20" R.Pine N39E 11.25' mrkd "1/4S" *
16" R.Pine S58W 35.4' do *	20" W.Pine S8E 13.7' do *
16" W.Pine S40E 28.95' mrkd "1/4S NBT"	7" Spruce N50W 8.75' mrkd "1/4S NBT"
6" Maple N57W 23.3' do	20" R.Pine S76W 8.4' do
Bearings are magnetic. Distances are to nail with tag. * denotes 1971 NBT.	Bearings are magnetic. Distances are to nail with tag. * denotes 1958 NBT.

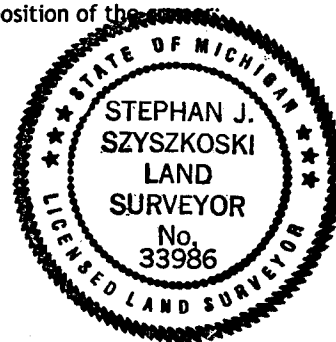

Signed by Stephan J. Szyszkoski  
 Surveyor's Michigan License No. 33986

Date 10/25/05

For the Michigan Department of Natural Resources, Office of Land and Facilities