



MAP SHEET  
TOWN 50N RANGE 9W

DATE	FILE NO.
DIVISION	DISTRICT
MAPPED BY:	
PHOTO NUMBERS	

COUNTY	TOWNSHIP	NUMBER OF ACRES
<u>Luce</u>		
OWNER OF LAND		
PURPOSE OF MAP		

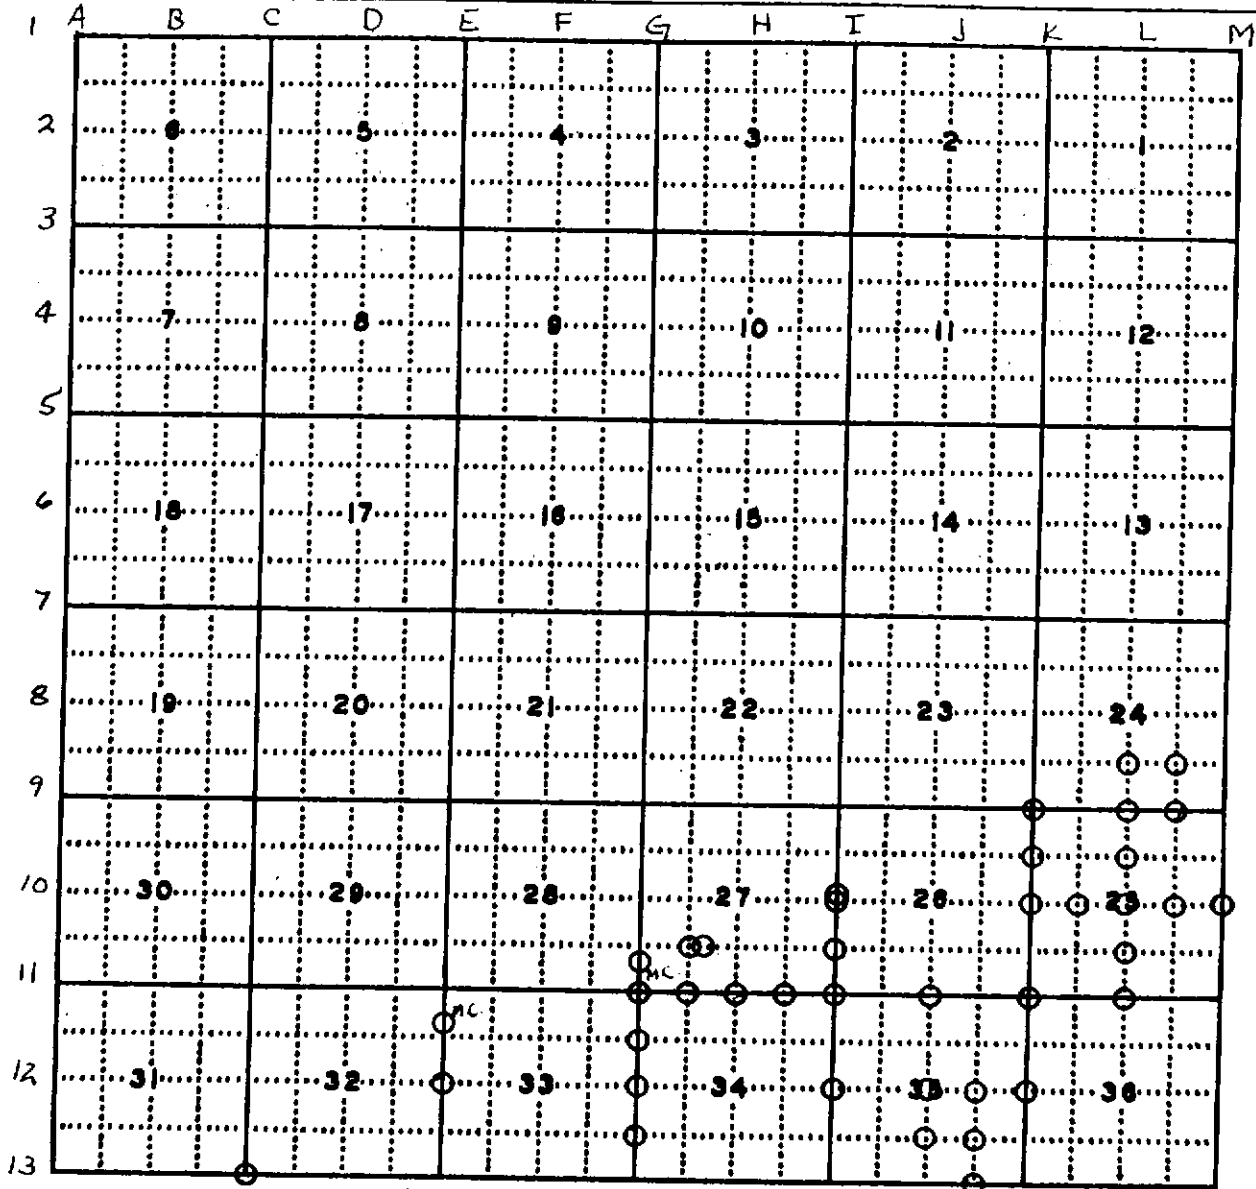

REMARKS

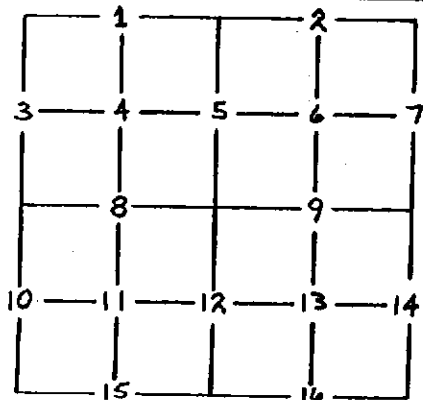

mc. - Meander Corner