

SURVEY &  
MONUMENTATION

MAR 13 2000

SECTION

LAND CORNER RECORDATION CERTIFICATE  
Filing Requirement of Act 74, Mich. P.A. 1970

For corners in

Luce (County)	Located In:	Corner Code #
1. Public Land Survey	T50N R12W	A 12 ✓
	T50N R13W	M 12
	T ___ R ___	___
	T ___ R ___	___
2. Property Controlling in Section	S ___ T ___ R ___	___
	S ___ T ___ R ___	___
3. Miscellaneous Property in Sec.	S ___ T ___ R ___	___
	S ___ T ___ R ___	___
4. Lot No. _____, Recorded Plat _____		
5. Private Claims _____		

LUCE COUNTY  
REGISTER OF DEEDS  
Recorded

Liber 3 Page 917  
02-08-2000 13:04:44  
Kathy S. Mahan  
Kathy S. Mahan, Register  
REGISTER OF DEEDS

Register of Deeds Stamp & File Number

	A	B	C	D	E	F	G	H	I	J	K	L	M
1													
2	6		5		4		3		2		1		
3													
4	7		8		9		10		11		12		
5													
6	18		17		16		15		14		13		
7													
8	19		20		21		22		23		24		
9													
10	30		29		28		27		26		25		
11													
12	31		32		33		34		35		36		
13													

I, Robert L. Jamros, in a field survey on March 6, 1996 do hereby state that under requirements of P.A. 74, Michigan P.A. of 1970, the corner points mentioned in lines 1 and 2 above were in conformance with regulations and rules therefore as required in the current manual of survey instructions of the United States Department of the Interior, Bureau of Land Management or by a decree of a Court of Law and/or that the corner points mentioned in lines 3, 4 and 5 above were in conformance with the rules of the Michigan Board of Land Surveyors or by a Decree of a Court of Law, established, re-established, monumented, recovered, found as expressed below:

NOTE: Not more than 2 corners, all in the same town and range, may be recorded on this certificate.

A. Description of original monument and accessories and/or subsequent restoration:


A12: PLS - John Burt, DS, 1841. \*\* Set qr. section post. \*\* N.Pine 6", S.21° W., 22 links; \*\* N.Pine, 6", N.12° W., 25 links. \*\*\*\* Michigan Department of Natural Resources, Billy D. Buckler, RLS, 1975. \*\* Corner reestablished at record distance North of township corner and on same bearing as the mile South. Found a wood post 11.3 feet West and 2.0 feet North. No evidence of original corner. \*\* Set 1" pipe with 4" aluminum cap and established the following references. \*\* J.Pine 6", N.75° E., 11.4 feet; \*\* J.Pine 6", S.78° W., 15.3 feet.

B. Description of corner evidence found and/or method applied in restoring or reestablishing corner:

A12: Found 1" G.I.P. with 4" aluminum cap and a 4" flat faced wood post, scribed. Also found two existing bearing trees as described in the report of 1975 in good condition. Both existing bearing trees renewed to current Alger County standards. Information acquired from the Michigan Department of Natural Resources documenting the method at which corner position was reestablished follows accepted methods. Established two additional witness trees. \*\* Monument position is accepted as a careful and faithful reestablishment of the position of the original corner.

C. Description of monument for corner and accessories established to perpetuate locating the position of the corner:

A12: Stamped P.A. 345 in existing 4" aluminum capped Department of Conservation monument. Renewed existing reference trees w/BT signs and paint. Established additional reference trees w/BT signs, blazed, scribed and painted. \*\* Set PK nails for measure w/aluminum T.D. washers in the following reference trees. \*\* Ex. J.Pine 10, N.78° E., 11.63 feet, "1/4s NBT"; \*\* Ex. J.Pine 7", N.76° W., 15.57 feet, "1/4s NBT"; \*\* J. Pine 6", S.32 1/2° E., 24.54 feet, "1/4s BT"; \*\* J.Pine 7", S.58° W., 29.88 feet, "1/4s BT". \*\* Survey marker sign on six foot steel post, N.12° W., 0.80 feet. \*\* All bearings are magnetic.

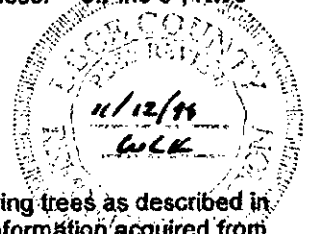

Signed by Robert L. Jamros Date June 12, 1996  
Surveyor's Michigan License No. 25849

