

SURVEY & MONUMENTATION

MAR 13 2000

LAND CORNER RECORDATION CERTIFICATE LUCE COUNTY
Filing Requirement of Act 74, Mich. P.A. 1970 REGISTER OF DEEDS

For corners **SECTION**

Recorded
Liber 3 Page 916
 02-08-2000 13:04:36
Kathy S. Mahan
 Kathy S. Mahan, Register
 REGISTER OF DEEDS

<u> </u> Luce (County)	Located In:	Corner Code #
1. Public Land Survey	T49N R12W T49N R13W T50N R12W	A 1 M 1 A-13
2. Property Controlling in Section	S <u> </u> T <u> </u> R <u> </u>	<u> </u>
3. Miscellaneous Property in Sec.	S <u> </u> T <u> </u> R <u> </u>	<u> </u>
4. Lot No. <u> </u> , Recorded Plat <u> </u>		
5. Private Claims <u> </u>		

Register of Deeds Stamp & File Number

A	B	C	D	E	F	G	H	I	J	K	L
1											
2	6		5		4		3		2		1
3											
4	7		8		9		10		11		12
5											
6	18		17		16		15		14		13
7											
8	19		20		21		22		23		24
9											
10	30		29		28		27		26		25
11											
12	31		32		33		34		35		36
13											

I, Robert L. Jamros, in a field survey on October 20, 1994 do hereby state that under requirements of P.A. 74, Michigan P.A. of 1970, the corner points mentioned in lines 1 and 2 above were in conformance with regulations and rules therefore as required in the current manual of survey instructions of the United States Department of the Interior, Bureau of Land Management or by a decree of a Court of Law and /or that the corner points mentioned in lines 3, 4 and 5 above were in conformance with the rules of the Michigan Board of Land Surveyors or by a Decree of a Court of Law, established, re-established, monumented, recovered, found as expressed below:

NOTE: Not more than 2 corners, all in the same town and range, may be recorded on this certificate.

A. Description of original monument and accessories and/or subsequent restoration:

A1: P.L.S. - John Burt, DS, for William A. Burt, DS, 1841. ** Set post corner of Towns 49 and 50 North, between Ranges 12 and 13 West. ** N.Pine 12", S.47° W., 85 links; ** N.Pine 8", N.35° E., 91 links. **** Subsequent restoration of authors unknown. **** Billy D. Buckler, RLS, 1975. * Found corner marked with 6" square stone monument, marked "U.S.L.H.E." ** New bearings: 8" J.Pine, N.23° E., 47.6 feet; ** 8" J.Pine, N.75° W., 28.8 feet. ** Corner Report #58 received from Michigan Department of Natural Resources.




B. Description of corner evidence found and/or method applied in restoring or reestablishing corner:

A1: Began at North 1/4 corner of Section 1, T.49N., R.13W. Ran a corrected compass line on GLO bearing East to 40.0 chains. Found 6"x6" granite monument scribed "U.S.L.H.E." on top. From monument located GLO BT locations, search inconclusive. Also located references from 1975 report. BT in NE position is dead and down and BT in NW position is dead but standing. From the monument position ran corrected compass line on GLO bearing North to 40.0 chains. Found 1 1/4" G.I.P. with 3 1/2" aluminum cap, State of Michigan, 7-9-75, R.L.S. no. 8887, stamped on cap. Accepted granite monument as the best available evidence of the position of the original corner. Area around corner position is an open Jack Pine plantation that in time past has been badly burned over.

C. Description of monument for corner and accessories established to perpetuate locating the position of the corner:

A1: Set 5/8"x5" Rebar with 3 1/2" aluminum cap stamped to identify corner position, drilled and grouted into the top of existing granite monument. ** Established reference trees w/BT signs, blazed, scribed and painted. ** Set PK nails for measure w/brass I.D. washers in the following reference trees. ** R.Pine 10", S.82° W., 40.81 feet, "S1 BT"; ** J.Pine 10", N.55° W., 45.22 feet, "S36 BT"; ** J.Pine 5", N.47 1/2° E., 57.30 feet, "S31 BT"; ** J Pine 5", S.25° E., 58.41 feet, "S6 BT". ** Steel witness post with survey marker sign, N.45° W., 2.0 feet. ** All bearings of are magnetic.

Signed by Robert L. Jamros
 Surveyor's Michigan license No. 25849

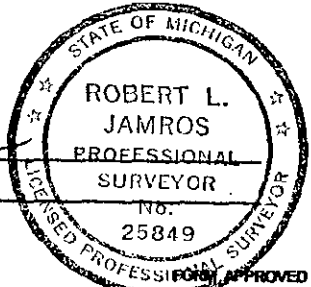

Date April 12, 1995