

SURVEY & REMONUMENTATION

FEB 25 1999

SECTION

LAND CORNER RECORDATION CERTIFICATE
Filing Requirement of Act 74, Mich. P.A. 1970

FILED

For corners in

LIVINGSTON
(County)

Located in:

Corner Code #

1. Public Land Survey

T 1 N R 3 E C8

2. Property Controlling in Section

S T R

3. Miscellaneous Property in Sec.

S T R

4. Lot No. _____, Recorded Plat _____


5. Private Claims _____

9- 1998 AUG 20 P 4: 42
NANCY HAVILAND
REGISTER OF DEEDS
LIVINGSTON COUNTY, MI,
48843
L.S.C. #862m
Register of Deeds Stamp & File Number

	A	B	C	D	E	F	G	H	I	J	K	L	M
1													
2	5		5		4		3		2		1		
3													
4	7		8		9		10		11		12		
5													
6	10		17		16		15		14		13		
7													
8	19		20		21		22		23		24		
9													
10	30		29		28		27		26		25		
11													
12	31		32		33		34		35		36		
13													

I, CHARLES E GARLOCK, in a field survey on AUG 8, 1998 do hereby state that under requirements of P.A. 74, Michigan P.A. of 1970, the corner points mentioned in lines 1 and 2 above were in conformance with regulations and rules therefore as required in the current manual of survey instructions of the United States Department of the Interior, Bureau of Land Management or by a decree of a Court of Law and/or that the corner points mentioned in lines 3, 4 and 5 above were in conformance with the rules of the Michigan Board of Land Surveyors or by a Decree of a Court of Law; established, re-established, monumented, recovered, found as expressed below:

NOTE: Not more than 2 corners, all in the same town and range, may be recorded on this certificate.

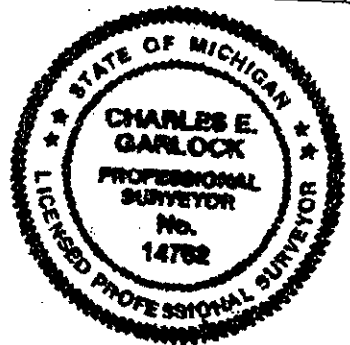

A. Description of original monument and accessories and/or subsequent restoration:
GLO SURVEY DATED APRIL 15, 1825 BY S SIBLEY
GLO WITNESSES: R07-S31½W-15 LKS
W032-N71½E-16 LKS

B. Description of corner evidence found and/or method applied in restoring or reestablishing corner:
DID NOT FIND AN IRON, REMAINING WITNESS AND LINE OF FENCES NORTH AND SOUTH FIT THE POINT WE RESET THE IRON, AS C WILSON DID, AT 1/2 DISTANCE AND ON LINE WITH THE SECTION CORNERS NORTH AND SOUTH

C. Description of monument for corner and accessories established to perpetuate locating the position of the corner:
C8: W 1/4 COR. SEC. 20 T1N-R3E, UNADILLA TWP. LIV. CO., MI, RESET WITH 1 1/4" X 36" BREAKAWAY I. PIPE WITH LIV. CO. REMON BRASS CAP ON TOP
N34E-64.91'-SP & TAG E/S 24' MAPLE
S38E-70.28'-SP & TAG N/S 24" MAPLE
S65W-44.86'-SP & TAG IN S'LY OF 7" TRIPLE AS
N20W-38.80'-SP & TAG S/S 8" ASH
NORTH-5'-CTR. OF OLD RAILROAD BED/NOW WALKING TRAIL.

Signed by

Charles E. Garlock

Date AUGUST 8, 1998

Surveyor's Michigan License No. 14762

P.A. 345 1990, APPROVED BY LIVINGSTON COUNTY
PEER GROUP ON 7/1/98 CO. REP JEO