

SURVEY & REMONUMENTATION

FEB 25 1999

SECTION

LAND CORNER RECORDATION CERTIFICATE
Filing Requirement of Act 74, Mich. P.A. 1970

FILED

For corners in

<u>LIVINGSTON</u> (County)	Located In:	Corner Code #
1. Public Land Survey	T <u>1N</u> R <u>3E</u>	<u>D7</u>
	T ___ R ___	_____
	T ___ R ___	_____
	T ___ R ___	_____
2. Property Controlling in Section	S ___ T ___ R ___	_____
	S ___ T ___ R ___	_____
3. Miscellaneous Property in Sec.	S ___ T ___ R ___	_____
	S ___ T ___ R ___	_____

9/

1998 AUG 20 P 4:43

NANCY HAVILAND
REGISTER OF DEEDS
LIVINGSTON COUNTY, MI.
48843

L.S.C. #865m
Register of Deeds Stamp & File Number

4. Lot No. _____, Recorded Plat _____
5. Private Claims _____


I, CHARLES E GARLOCK, in a field survey on AUG. 10, 1998 do hereby state that under requirements of P.A. 74, Michigan P.A. of 1970, the corner points mentioned in lines 1 and 2 above were in conformance with regulations and rules therefore as required in the current manual of survey instructions of the United States Department of the Interior, Bureau of Land Management or by a decree of a Court of Law and /or that the corner points mentioned in lines 3, 4 and 5 above were in conformance with the rules of the Michigan Board of Land Surveyors or by a Decree of a Court of Law; established, re-established, monumented, recovered, found as expressed below:

NOTE: Not more than 2 corners, all in the same town and range, may be recorded on this certificate.

1	A	B	C	D	E	F	G	H	I	J	K	L	M
2		6		5		4		3		2		1	
3													
4		7		8		9		10		11		12	
5													
6		18		17		16		15		14		13	
7													
8		19		20		21		22		23		24	
9													
10		30		29		28		27		26		25	
11													
12		31		32		33		34		35		36	
13													

A. Description of original monument and accessories and/or subsequent restoration:
GLO SURVEY DATED APRIL 15, 1825 BY S SIBLEY
GLO WITNESSES: W012-N6½E-37 LKS
W08-S71E-45 LKS

B. Description of corner evidence found and/or method applied in restoring or reestablishing corner:
FOUND 1/2" I. ROD ON CTR. OF ASPHALT ROAD

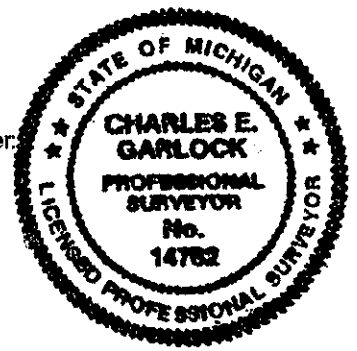

C. Description of monument for corner and accessories established to perpetuate locating the position of the corner:
D7: N 1/4 SEC. 20, T1N-R3E, UNADILLA TWP. LIV. CO. MI., REPLACED 1/2" I. ROD WITH MON BOX AND 1 1/4" X 36" BREAKAWAY I. PIPE WITH LIV. CO. REMON BRASS CAP ON TOP.
N85E-115.71'-SP & TAG S/S 24" HICKORY
S5E-26.45'-SP & TAG E/S 12" HICKORY
S45W-38.41'-SP & TAG E/S 36" OAK
N50W-45.54'-SP & TAG S/S 30" OAK

Signed by Charles E. Garlock
Surveyor's Michigan License No. 14762

Date AUGUST 11, 1998

P.A. 345 1990, APPROVED BY LIVINGSTON COUNTY
PEER GROUP ON 7/1/98, CO. REP VED