

FILED

Oct 16 11 43 AM '95

LAND CORNER RECORDATION CERTIFICATE  
Filing Requirement of Act 74, Mich. P.A. 1970

NANCY HAYILANI  
REGISTER OF DEEDS  
LIVINGSTON COUNTY, MI  
48843

corners in

LIVINGSTON (County)	Located In:	Corner Code #
Public Land Survey	T <u>1N</u> R <u>3E</u>	<u>D-13</u>
	T _____ R _____	_____
	T _____ R _____	_____
	T _____ R _____	_____
Property Controlling	S _____ T _____ R _____	_____
In Section	S _____ T _____ R _____	_____
Miscellaneous	S _____ T _____ R _____	_____
Property in Sec.	S _____ T _____ R _____	_____

L.S.C.# 489m

Register of Deeds Stamp & File Number

Lot No. \_\_\_\_\_, Recorded Plat \_\_\_\_\_  
Private Claims \_\_\_\_\_

A	B	C	D	E	F	G	H	I	J	K	L	M
2	6	5	4	3	2	1						
3												
4	7	8	9	10	11	12						
5												
6	18	17	16	15	14	13						
7												
8	19	20	21	22	23	24						
9												
10	30	29	28	27	26	25						
11												
12	31	32	33	34	35	36						
13												

UNADILLA TWP.

SURVEY &  
REMONUMENTATION

NOV 27 1995

COMMISSION

DARRELL HUGHES, in a field survey on MAY ~~JANUARY 18~~, 1995,  
hereby certify that under requirements of P.A. 74, Michigan P.A. of 1970, the corner points mentioned  
lines 1 and 2 above were in conformance with regulations and rules therefore as required in the  
current manual of survey instructions of the United States Department of the Interior, Bureau of Land  
Management or by a decree of a Court of Law and/or that the corner points mentioned in lines 3, 4 and 5  
above were in conformance with the rules of the Michigan Board of Land Surveyors or by a Decree of a  
Court of Law; established, re-established, monumented, re-monumented, recovered, found as  
expressed below:


NOTE: Not more than 4 corners, all in the same town and range, may be recorded  
on this certificate.

Description of original monument and accessories and/or subsequent restoration:  
GLO: 1825, Sylvester Sibley, Deputy Surveyor  
Black Oak 10", North 68 degrees East, 30 links  
Black Oak 5", North 23 degrees West, 14-1/2 links

Description of corner evidence found and/or method applied in restoring or reestablishing corner:  
Found 1/2 inch iron rod.

\*Additional descriptions and historical information on back of this sheet.

Description of monument for corner and accessories established to perpetuate locating the position of the corner:  
D-13, T1N, R3E, UNADILLA, replaced existing corner with 1-1/4" X 36" iron  
pipe, affixed with 2" dia. brass cap, stamped "Livingston Co.  
Monumentation Corner, P.S. 19834, and is accepted as a careful and  
faithful reestablishment of the position of the original corner.  
331 DEG. 116.79' SE COR. CONC. BLOCK HOUSE.  
120 DEG. 71.17' SET NAIL/TAG NE/S 12" WALNUT.  
210 DEG. 30.89' SET NAIL/TAG SE/S 10" ELM.  
248 DEG. 61.76' SET NAIL/TAG S/S 14" OAK.  
041 DEG. 61.42' SET NAIL/TAG SE/S 8" TWIN MAPLE.  
270 DEG. 238.82' TO C-1, T1S, R3E.

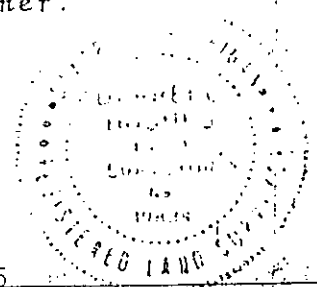

signed by Darrell Hughes Date October 5, 1995  
Surveyor's Michigan License No. 19894

UNADILLA TOWNSHIP, T1N, R3E

D-13, SOUTH 1/4 CORNER SECTION 32 AT MICHIGAN BASE LINE.

FIELD 1-18-1995 DARRELL D. HUGHES AND ASSOCIATES, FOWLERVILLE.

Found 1/2" smooth iron rod (bent), straightened and reset, 3' south of centerline Bowdish Road and 1' east of centerline of Worden Road to North. Measurement to C-1, Lyndon Twp. 238.82'. Found Wilson witness', we agree. Found 100+/- year old Yokam tie to house that agrees. No other reference measures to other section corners found.

1825 Sylvester Sibley, Deputy U.S. Surveyor, "West on the south boundary of Section 32, 40.00 chains, set 1/4 section post". P.7c

1887 ? John T. Yokam SE cor. house N 37 1/2 deg.W. 1.75 1/2 chains (116.49') (Hughes 1995, 331 Deg. 116.79') P.8

1973 Ron Lester, Polaris Assoc. found corner for survey in SE1/4 Section 31. shows above house tie as 110.00'. P.10

1991 Charles Wilson field witness' were found and we agree. P.13

1995 Hughes field witness'. P.14

116.80 JFB