

FEB 25 1999

**SECTION**

**LAND CORNER RECORDATION CERTIFICATE**  
Filing Requirement of Act 74, Mich. P.A. 1970

**FILED**

For corners in

<u>LIVINGSTON</u> (County)	Located In:	Corner Code #
1. Public Land Survey	T1N R3E	E8
	T R	
	T R	
	T R	
2. Property Controlling in Section	S T R	
	S T R	
3. Miscellaneous Property in Sec.	S T R	
	S T R	

9 / 1998 AUG 20 P 4: 42  
NANCY HAVILAND  
REGISTER OF DEEDS  
LIVINGSTON COUNTY, MI.  
48843

L.S.C. #861m  
Register of Deeds Stamp & File Number

4. Lot No. \_\_\_\_\_, Recorded Plat \_\_\_\_\_  
5. Private Claims \_\_\_\_\_

CHARLES E GARLOCK AUG. 4, 1998


I, \_\_\_\_\_, in a field survey on \_\_\_\_\_, 19\_\_\_\_ do hereby state that under requirements of P.A. 74, Michigan P.A. of 1970, the corner points mentioned in lines 1 and 2 above were in conformance with regulations and rules therefore as required in the current manual of survey instructions of the United States Department of the Interior, Bureau of Land Management or by a decree of a Court of Law and /or that the corner points mentioned in lines 3, 4 and 5 above were in conformance with the rules of the Michigan Board of Land Surveyors or by a Decree of a Court of Law; established, re-established, monumented, recovered, found as expressed below:

NOTE: Not more than 2 corners, all in the same town and range, may be recorded on this certificate.

1	A	B	C	D	E	F	G	H	I	J	K	L	M
2	6		5		4		3		2		1		
3													
4	7		8		9		10		11		12		
5													
6	18		17		16		15		14		13		
7													
8	19		20		21		22		23		24		
9													
10	30		29		28		27		26		25		
11													
12	31		32		33		34		35		36		
13													

A. Description of original monument and accessories and/or subsequent restoration:

GLO SURVEY DATED APRIL 15, 1825 BY S SIBLEY  
GLO WITNESSES: B028-S27W-56 LKS  
WO 20-N34W-134 LKS

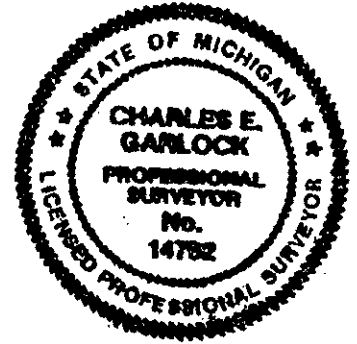

B. Description of corner evidence found and/or method applied in restoring or reestablishing corner:

FOUND 1/2" I. ROD ABOUT 50 FT. NORTH OF OLD RAILROAD BED AND 6.5 FT. EAST OF NORTH-SOUTH ROAD CENTERLINE.

C. Description of monument for corner and accessories established to perpetuate locating the position of the corner:

E8: EAST 1/4 COR. SEC. 20 T1N-R3E, UNADILLA TWP. LIV. CO. MI, RESET FD. 1/2" I. ROD WITH 1 1/4" X 36" BREAKAWAY I, PIPE W/ LIV. CO. REMON BRASS CAP ON TOP  
N21E-38.59'-SP & TAG W/S 18" LOCUST  
N63E-16.61'-SP 7 TAG N/S 14" LOCUST  
S23E-42.74'-SP & TAG N/S 10" LOCUST  
N33W-55.08'-SP & TAG E/S NE'LY DBL 20" CHERRY

Signed by Charles E. Garlock  
Surveyor's Michigan License No. 14762

Date AUGUST 8, 1998