

FEB 25 1999

SECTION

LAND CORNER RECORDATION CERTIFICATE
Filing Requirement of Act 74, Mich. P.A. 1970

FILED

For corners in

LIVINGSTON
(County)

Located in:

Corner Code #

- 1. Public Land Survey T1N R3E E9
 T R
 T R
 T R
- 2. Property Controlling S T R
 in Section S T R
- 3. Miscellaneous S T R
 Property in Sec. S T R

91
 1998 AUG 20 P 4: 42
 NANCY HAVILAND
 REGISTER OF DEEDS
 LIVINGSTON COUNTY, MI.
 48843
 L.S.C. #860m
 Register of Deeds Stamp & File Number

- 4. Lot No. _____, Recorded Plat _____
- 5. Private Claims _____

I, CHARLES E. GARLOCK in a field survey on AUG 4, 1998 do hereby state that under requirements of P.A. 74, Michigan P.A. of 1970, the corner points mentioned in lines 1 and 2 above were in conformance with regulations and rules therefore as required in the current manual of survey instructions of the United States Department of the Interior, Bureau of Land Management or by a decree of a Court of Law and /or that the corner points mentioned in lines 3, 4 and 5 above were in conformance with the rules of the Michigan Board of Land Surveyors or by a Decree of a Court of Law; established, re-established, monumented, recovered, found as expressed below:


NOTE: Not more than 2 corners, all in the same town and range, may be recorded on this certificate.

	A	B	C	D	E	F	G	H	I	J	K	L	M
1													
2		6		5		4		3		2		1	
3													
4		7		8		9		10		11		12	
5													
6		18		17		16		15		14		13	
7													
8		19		20		21		22		23		24	
9													
10		30		29		28		27		26		25	
11													
12		31		32		33		34		35		36	
13													

A. Description of original monument and accessories and/or subsequent restoration:
 GLO SURVEY DATED APRIL 15, 1825 BY S SIBLEY AND NONE OF THE GLO WITNESSES REMAIN.
 GLO WITNESSES: B012-S75W-12 LKS
 W06-S58½E-38 LKS

ADDITIONAL DATA ON REAR OF SHEET

B. Description of corner evidence found and/or method applied in restoring or reestablishing corner:
 FOUND 1/2" I. ROD 1' EAST OF CTR. GRAVEL ROAD, FENCE LINE TO THE EAST

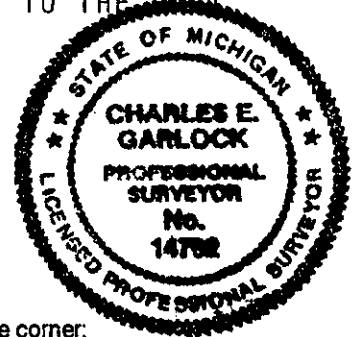

C. Description of monument for corner and accessories established to perpetuate locating the position of the corner:
 E9: SE COR. SEC. 20 T1N-R3E, UNADILLA TWP; LIV. CO. MI, RESET 1/2" I. ROD WITH 1 1/4" X 36" BREAKAWAY I. PIPE WITH LIV. CO. REMON BRASS CAP ON TOP
 N24E-59.86'-SP & TAG W/S 10" CHERRY
 S12E-95.22'-SP & TAG W/S 45" HICKORY
 N84W-41.10'-SP & TAG N/S 24" HICKORY
 N40W-38.24'-SP & TAG E/S 28" OAK

Signed by Charles E. Garlock
 Surveyor's Michigan License No. 14762

Date AUGUST 8, 1998