

FILED

Oct 16 11 43 AM '95

NANCY HAVILAND
REGISTER OF DEEDS
LIVINGSTON COUNTY, MI
48843

LAND CORNER RECORDATION CERTIFICATE
Filing Requirement of Act 74, Mich. P.A. 1970

corners in
LIVINGSTON
 (County)

Located In: Corner Code #

Public Land Survey T 1N R 3E E-13
 T _____ R _____
 T _____ R _____
 T _____ R _____

Property Controlling S _____ T _____ R _____
 in Section S _____ T _____ R _____
 Miscellaneous S _____ T _____ R _____
 Property in Sec. S _____ T _____ R _____

L.S.C.# 490m

Register of Deeds Stamp & File Number

Lot No. _____, Recorded Plat _____
Private Claims _____

DARRELL HUGHES, in a field survey on MAY
JANUARY 18, 1995,
hereby certify that under requirements of P.A. 74, Michigan P.A. of 1970, the corner points mentioned
in lines 1 and 2 above were in conformance with regulations and rules therefore as required in the
current manual of survey instructions of the United States Department of the Interior, Bureau of Land
Management or by a decree of a Court of Law and/or that the corner points mentioned in lines 3, 4 and 5
above were in conformance with the rules of the Michigan Board of Land Surveyors or by a Decree of a
Court of Law; established, re-established, monumented, re-monumented, recovered, found as
restored below:

NOTE: Not more than 4 corners, all in the same town and range, may be recorded
on this certificate.

Description of original monument and accessories and/or subsequent restoration:
GLO: 1825, Sylvester Sibley, Deputy Surveyor
White Oak 18", North 12 degrees East, 90 links
White Oak 7", North 31 degrees West, 121 links

	A	B	C	D	E	F	G	H	I	J	K	L	M
2	6		5		4		3		2		1		
3													
4	7		8		9		10		11		12		
5													
6	18		17		16		15		14		13		
7													
8	19		20		21		22		23		24		
9													
10	30		29		28		27		26		25		
11													
12	31		32		33		34		35		36		
13													

UNADILLA TWP.

SURVEY &
REMONUMENTATION

NOV 27 1995

COMMISSION


Description of corner evidence found and/or method applied in restoring or reestablishing corner:
Found 1/2 inch iron rod

*Additional descriptions and historical information on back of sheet.

Description of monument for corner and accessories established to perpetuate localing the position of the corner:

E-13, T1N, R3E, UNADILLA, replaced existing corner with 1-1/4" X 36" iron
pipe, affixed with 2" dia. brass cap, stamped "Livingston Co.
Monumentation Corner, P.S. 19834, and is accepted as a careful and
faithful reestablishment of the position of the original corner.
270 DEG. 371.38' TO D-1, T1S, R3E.
360 DEG. 33.01' FD. 1/2" IRON ROD.
326 DEG. 52.09' SET NAIL/TAG SE/S 36" OAK.
287 DEG. 99.63' SET NAIL/TAG S/S 30" OAK.
196 DEG. 51.31' SET NAIL/TAG E/S 4" POPLAR.
063 DEG. 49.26' SET NAIL/TAG SE/S 4" OAK.

Recorded by Darrell Hughes Date October 5, 1995
Surveyor's Michigan License No. 19834

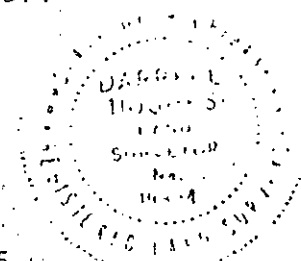

FORM APPROVED BY MICHIGAN STATE BOARD OF LAND SURVEYORS, JAN. 28, 1971
REVISED MAY 14, 1975
REVISED JAN., 1993

P.A. 345 1980, APPROVED BY LIVINGSTON COUNTY

RECORDED ON 5-17-95 CO. REP JED

UNADILLA TOWNSHIP, T1N, R3E

E-13, SOUTHEAST CORNER SECTION 32 AND SOUTHWEST CORNER SECTION 33 AT MICHIGAN BASE LINE.

FIELD 1-18-1995 DARRELL D. HUGHES AND ASSOCIATES, FOWLerville.

Found 1/2" iron rod with Boss cap at south edge Bowdish Road. Found and checked two of Boss' witness'. Found 1/2" iron rod 33.01' north. E-13 to F-13, Hughes, 1995, 2675.76', Boss, 1986, 2680.00'. Rough distance to D-1 (iron found with Lester cap, iron (ying flat) 371.4', Boss 371.48'.

1825 Sylvester Sibley, Deputy U.S. Surveyor, "West on the South boundary of Section 33....80.00 chains set post common to sections 32 and 33." P.7

1972 Ron Lester files Act 74 for D-1, Lyndon Twp. P.9

1976 Garlock survey shows distance from D-1 to F-13. P. 9A

1977 Washtenaw Engineering survey NW 1/4 Section 5, Lyndon - Twp. shows witness' to D-1 (copies Lester). P.10

1986 Boss sets 1/2" iron rod and shows witness'. P.11

1995 Hughes finds Boss iron and checks witness'. P.12