

FILED

Oct 16 11 43 AM '95

LAND CORNER RECORDATION CERTIFICATE
Filing Requirement of Act 74, Mich. P.A. 1970

NANCY HAVILAND
REGISTER OF DEEDS
LIVINGSTON COUNTY, MI
48843

For corners in

<u>LIVINGSTON</u> (County)	Located In:	Corner Code #
Public Land Survey	T <u>1N</u> R <u>3E</u>	<u>F-13</u>
	T _____ R _____	_____
	T _____ R _____	_____
	T _____ R _____	_____
Property Controlling in Section	S _____ T _____ R _____	_____
Miscellaneous	S _____ T _____ R _____	_____
Property in Sec.	S _____ T _____ R _____	_____

L.S.C.# 491m

Register of Deeds Stamp & File Number

Lot No. _____, Recorded Plat _____
Private Claims _____

DARRELL HUGHES, in a field survey on MAY JANUARY 18, 19 95,
hereby certify that under requirements of P.A. 74, Michigan P.A. of 1970, the corner points mentioned
in lines 1 and 2 above were in conformance with regulations and rules therefore as required in the
current manual of survey instructions of the United States Department of the Interior, Bureau of Land
Management or by a decree of a Court of Law and/or that the corner points mentioned in lines 3, 4 and 5
above were in conformance with the rules of the Michigan Board of Land Surveyors or by a Decree of a
Court of Law; established, re-established, monumented, re-monumented, recovered, found as
expressed below:

A	B	C	D	E	F	G	H	I	J	K	L	M
2	6	5	4	3	2	1						
3												
4	7	8	9	10	11	12						
5												
6	13	17	16	15	14	13						
7												
8	19	20	21	22	23	24						
9												
10	30	29	28	27	26	25						
11												
12	31	32	33	34	35	36						
13												

UNADILLA TWP.

NOTE: Not more than 4 corners, all in the same town and range, may be recorded on this certificate.

Description of original monument and accessories and/or subsequent restoration:
GLO: 1825, Sylvester Sibley, Deputy Surveyor
White Oak 12", North 71 degrees West, 38 links
White Oak 14", North 62-1/2 degrees East, 77 links

SURVEY &
REMONUMENTATION


NOV 27 1995

COMMISSION

Description of corner evidence found and/or method applied in restoring or reestablishing corner:
Found 1/2 inch iron rod.

Additional descriptions and historical information on back of this sheet:

Description of monument for corner and accessories established to perpetuate locating the position of the corner:
F-13, T1N, R3E, UNADILLA, replaced existing corner with 1-1/4" X 36" iron pipe, affixed with 2" dia. brass cap, stamped "Livingston Co. Monumentation Corner, P.S. 19834, and is accepted as a careful and faithful reestablishment of the position of the original corner.
270 DEG. 397.65' TO E-1, T1S, R3E.
082 DEG. 60.16' SET NAIL/TAG S/S 60" QUAD. OAK.
318 DEG. 18.85' SET NAIL/TAG SW/S 8" WALNUT.
251 DEG. 63.45' SET NAIL/TAG N/S 14" RED PINE.
117 DEG. 64.87' SET NAIL/TAG N/S 16" RED PINE.
021 DEG. 22.04' SET NAIL/TAG W/S 18" OAK.

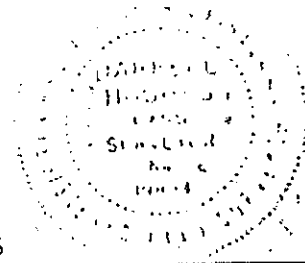

Signed by Darrell Hughes Date October 5, 1995
Surveyor's Michigan License No. 19834

UNADILLA TOWNSHIP, T1N, R3E

F-13, SOUTH 1/4 CORNER SECTION 33 AT MICHIGAN BASE LINE.

FIELD 1-18-1995 DARRELL D. HUGHES AND ASSOCIATES, FOWLerville.

Recovered 1/2" iron rod as witnessed in 1994 remonumentation program. no cap found. Measurements check Garlock 1990 (reset corner) and witness'. F-13 to E-13, Boss 1986, 2680.00', Hughes 1995 2675.76'. F-13 to F-1 Lyndon Twp. Hughes 1995, 2251.85', Garlock 1990, 2251.85', Wolverine (George Young) 1977, 2247.46', Garlock 1976, 2248.24', Lyle Munsell 1967, 2312.8'.

1825 Sylvester Sibley, Deputy U.S. Surveyor, " West on the South boundary of Section 33....40.00 chains set 1/4 section post". P.7

1967 Lyle Munsell survey. P.10

1972 Washtenaw Co. Rd. Comm. witness'. P.11

1974 Garlock Survey sets corner with 1/2" iron rod. P.12

1976 Garlock survey resets corner by fence line to north and East-West road line fence split. P.13

1976 Garlock resets corner again. P.14

1976 Garlock files Act 74. P15

1977 George Young uses corner in survey. new witness'. P.16

1979 Garlock shows corner in survey. Corner still at fence split. P.17

1986 Boss uses corner in survey and copies Garlock witness'. P.18

1990 Garlock finds corner in survey and makes new witness' to ctr.(center?) of trees. P.19

1990 Garlock files Act 74. P.20

1992 Garlock field notes show finding corner. P.21

1994 Hughes 1994 remonumentation field witness'. P.22