

SURVEY & REMONUMENTATION

APR 28 1995

LAND CORNER RECORDATION CERTIFICATE
Filing Requirement of Act 74, Mich. P.A. 1970

Nov 16 2 00 PM '94

FILED

For corners in **COMMISSION**

LIVINGSTON
(County)

Located In:

Corner Code #

- | | | | | | | |
|------------------------------------|---|-----------|---|-----------|-------------|-------|
| 1. Public Land Survey | T | <u>1N</u> | R | <u>3E</u> | <u>G-12</u> | |
| | T | _____ | R | _____ | _____ | |
| | T | _____ | R | _____ | _____ | |
| | T | _____ | R | _____ | _____ | |
| 2. Property Controlling in Section | S | _____ | T | _____ | R | _____ |
| | S | _____ | T | _____ | R | _____ |
| 3. Miscellaneous Property in Sec. | S | _____ | T | _____ | R | _____ |
| | S | _____ | T | _____ | R | _____ |

NANCY HAVILAND
REGISTER OF DEEDS
LIVINGSTON COUNTY, MI
48843

L.S.C.#336m
Register of Deeds Stamp & File Number

4. Lot No. _____, Recorded Plat _____
5. Private Claims _____

DARRELL HUGHES, in a field survey on NOVEMBER 4,, 19 94,
do hereby certify that under requirements of P.A. 74, Michigan P.A. of 1970, the corner points mentioned in lines 1 and 2 above were in conformance with regulations and rules therefore as required in the current manual of survey instructions of the United States Department of the Interior, Bureau of Land Management or by a decree of a Court of Law and/or that the corner points mentioned in lines 3, 4 and 5 above were in conformance with the rules of the Michigan Board of Land Surveyors or by a Decree of a Court of Law, established, re-established, monumented, re-monumented, recovered, found as expressed below:

-NOTE: Not more than 4 corners, all in the same town and range, may be recorded on this certificate.

6. Description of original monument and accessories and/or subsequent restoration:

GLO: 1825 Sylvester Sibley, Deputy Surveyor
Black Oak 18" North 15 degrees West 158 links
Black Oak 10" South 53 degrees East 166 links

	A	B	C	D	E	F	G	H	I	J	K	L	M
2		6		5		4		3		2		1	
3													
4		7		8		9		10		11		12	
5													
6		18		17		16		15		14		13	
7													
8		19		20		21		22		23		24	
9													
10		30		29		28		27		26		25	
11													
12		31		32		33		34		35		36	
13													

UNADILLA TWP.


*Additional historical information on back of sheet

7. Description of corner evidence found and/or method applied in restoring or reestablishing corner:

Fd. railroad spike in centerline of asphalt road

Description of monument for corner and accessories established to perpetuate locating the position of the corner:

G-12, T1N, R3E, UNADILLA, replaced existing corner with 1-1/4" X 36" iron pipe, affixed with 2" dia. brass disk. Disk stamped "Livingston Co. Monumentation Corner, 19834" in road box and is accepted as a careful and faithful reestablishment of the position of the original corner.
033 DEG. 32.26' SET NAIL/TAG SE/S 30" MAPLE.
002 DEG. 43.80' SET NAIL/TAG W/S 28" PINE.
115 DEG. 106.88' SET NAIL/TAG N/S 12" ELM.
204 DEG. 67.89' SET NAIL/TAG E/S 8" TREE.
002 DEG. 33.13' FD. 3/4" IRON PIPE 17620.

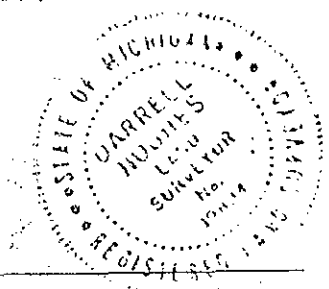

Signed by Darrell Hughes Date 11-8-94
Surveyor's Michigan License No. 19834

FORM APPROVED BY MICHIGAN STATE BOARD OF LAND SURVEYORS, JAN. 28, 1971
REVISED MAY 14, 1975
REVISED JAN., 1983

PA. 345 1990, APPROVED BY LIVINGSTON COUNTY
REC'D GROUP ON 17 Aug 94 CO. REP [Signature]

G-12, WEST 1/4 COR. SEC. 34, EAST 1/4 COR. SEC. 33, T1N, R3E, UNADILLA TWP.

FOUND RAILROAD SPIKE IN CENTERLINE WILLIAMSVILLE ROAD (ASPHALT), 3' WEST OF CENTERLINE OF ROEPKE ROAD (GRAVEL) TO SOUTH. FOUND TWO OLDER WITNESS' THAT CHECK AND 33 FT IRON PIPE (NNF 17620) TO NORTH.

1825 Sylvester Sibley, Deputy U.S. Surveyor set post at 40 chains from south.

1971 Oscar Boss survey found 1/2" iron and files Act 74. P.8-9.

1973 Boss revises same survey. P.10

1981 Austin Williams sketch, copys Boss witness', does not say what physical corner is. P. 11

1988 Wilson/Eckfeld find railroad spike and measure witness'. P.14, 16.

1992 Garlock ALTA survey (P.19), files Act 74. P.20. gives measures West to Center of Section 33 and Roepke Road measures.(agree close with Boss P.10)

OK for GPS