

**SURVEY &  
REMONUMENTATION**

APR 28 1995

**LAND CORNER RECORDATION CERTIFICATE**  
Filing Requirement of Act 74, Mich. P.A. 1970

**FILED**

Nov 16 2 00 PM '94

NANCY HAVILAND  
REGISTER OF DEEDS  
LIVINGSTON COUNTY, MI  
48843

or corners in

**LIVINGSTON COMMISSION**  
(County)

Located In:

Corner Code #

Public Land Survey	T	<u>1N</u>	R	<u>3E</u>	<u>I-11</u>
	T		R		
	T		R		
	T		R		
Property Controlling in Section	S		T		
Miscellaneous	S		T		
Property in Sec.	S		T		

L.S.C.#340m

Register of Deeds Stamp & File Number

Lot No. \_\_\_\_\_, Recorded Plat \_\_\_\_\_  
Private Claims \_\_\_\_\_

DARRELL HUGHES, in a field survey on NOVEMBER 4, 19 94,

do hereby certify that under requirements of P.A. 74, Michigan P.A. of 1970, the corner points mentioned in lines 1 and 2 above were in conformance with regulations and rules therefore as required in the current manual of survey instructions of the United States Department of the Interior, Bureau of Land Management or by a decree of a Court of Law and/or that the corner points mentioned in lines 3, 4 and 5 above were in conformance with the rules of the Michigan Board of Land Surveyors or by a Decree of a Court of Law; established, re-established, monumented, re-monumented, recovered, found as expressed below:

**NOTE: Not more than 4 corners, all in the same town and range, may be recorded on this certificate.**

Description of original monument and accessories and/or subsequent restoration:

GLO: 1825 Sylvester Sibley, Deputy Surveyor  
Black Oak 15" North 36 degrees East 50 links  
Black Oak 14" South 34 degrees West 4 links

\*Additional historical information on back of sheet

Description of corner evidence found and/or method applied in restoring or reestablishing corner:

Fd. 1/2" iron re-rod at fence corner


	A	B	C	D	E	F	G	H	I	J	K	L	M
2	6		5		4		3		2				
3													
4	7		8		9		10		11		12		
5													
6	18		17		16		15		14		13		
7													
8	19		20		21		22		23		24		
9													
10	30		29		28		27		26		25		
11													
12	31		32		33		34		35		36		
13													

UNADILLA TWP.

Description of monument for corner and accessories established to perpetuate locating the position of the corner:

I-11, T1N, R3N, UNADILLA, replaced existing corner with 1-1/4" X 36" iron pipe, affixed with 2" dia. brass disk. Disk stamped "Livingston Co. Monumentation Corner, 19834" and is accepted as a careful and faithful reestablishment of the position of the original corner.  
005 DEG. 7.44' SET NAIL/TAG E/S 36" OAK.  
101 DEG. 29.08' SET NAIL/TAG S/S 11" CHERRY.  
219 DEG. 18.77' SET NAIL/TAG NW/S 14" SASSAFRAS.  
272 DEG. 25.05' SET NAIL/TAG N/S 8" SASSAFRAS.

Signed by Darrell Hughes Date 11-8-94  
Surveyor's Michigan License No. 19834

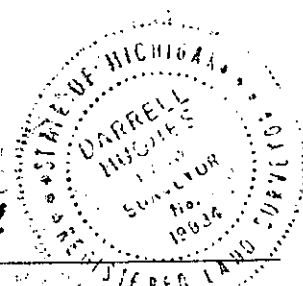

FORM APPROVED BY MICHIGAN STATE BOARD OF LAND SURVEYORS; JAN. 28, 1971  
REVISED MAY 14, 1975  
REVISED JAN., 1983

PA. 345 1990, APPROVED BY LIVINGSTON COUNTY  
PEER GROUP ON 17 Aug 94, CO. REP Rob L.

I-11, CORNER COMMON TO SECTIONS 27, 28, 33 AND 34, T1N, R3E, UNADILLA TWP.

FOUND 1/2" IRON RE-ROD 6" NORTHWEST OF CORNER FENCE POST, WIRE E,W AND NORTH. OLDER WITNESS' CHECK.

1825 Sylvester Sibley, Deputy U.S. Surveyor, set post at 80 chains from south. P.7

1874 Miles Bullock surveys part of Northwest 1/4. measures 5258.82' south to I-12. P.8.

1973 Oscar Boss survey calls for "fence intersection", no witness'.

1987 January, Hughes finds 1/2" re-rod and files Act 74. P.10-11.

1987 December, Boss uses corner in survey, copys Hughes witness'. P.12. 5243.14' south to I-12.

1988 Wilson uses corner in survey, copys Hughes witness'. P.13

1990 Eckfeld/Wilson uses corner, copys witness'. 5239.37' South to I-12. P.15.

Poor location for GPS.