

**SURVEY &
REMONUMENTATION**

FILED

APR 28 1995

LAND CORNER RECORDATION CERTIFICATE
Filing Requirement of Act 74, Mich. P.A. 1970

Nov 16 2 00 PM '94

For corners in **COMMISSION**

NANCY HAVILAND
REGISTER OF DEEDS
LIVINGSTON COUNTY, MI
48843

<u>LIVINGSTON</u> (County)	Located In:	Corner Code #
1. Public Land Survey	T <u>1N</u> R <u>3E</u>	<u>I-12</u>
	T _____ R _____	_____
	T _____ R _____	_____
	T _____ R _____	_____
2. Property Controlling in Section	S _____ T _____ R _____	_____
	S _____ T _____ R _____	_____
3. Miscellaneous Property in Sec.	S _____ T _____ R _____	_____
	S _____ T _____ R _____	_____

L.S.C.# 341m
Register of Deeds Stamp & File Number

4. Lot No. _____, Recorded Plat _____
5. Private Claims _____

	A	B	C	D	E	F	G	H	I	J	K	L	M
2	6		5		4		3		2		1		
3													
4	7		8		9		10		11		12		
5													
6	18		17		16		15		14		13		
7													
8	19		20		21		22		23		24		
9													
10	30		29		28		27		26		25		
11													
12	31		32		33		34		35		36		
13													

DARRELL HUGHES, in a field survey on NOVEMBER 4, 19 94,
do hereby certify that under requirements of P.A. 74, Michigan P.A. of 1970, the corner points mentioned
in lines 1 and 2 above were in conformance with regulations and rules therefore as required in the
current manual of survey instructions of the United States Department of the Interior, Bureau of Land
Management or by a decree of a Court of Law and/or that the corner points mentioned in lines 3, 4 and 5
above were in conformance with the rules of the Michigan Board of Land Surveyors or by a Decree of a
Court of Law; established, re-established, monumented, re-monumented, recovered, found as
expressed below:

**NOTE: Not more than 4 corners, all in the same town and range, may be recorded
on this certificate.**

UNADILLA TWP.

6. Description of original monument and accessories and/or subsequent restoration:

GLO: 1825 Sylvester Sibley, Deputy Surveyor
Black Oak 17" South 5 degrees East 17 links
Black Oak 13" South 80 degrees East 214 links


*Additional historical information on back of sheet

7. Description of corner evidence found and/or method applied in restoring or reestablishing corner:

Fd. 3/4" iron pipe in N/S fence line

8. Description of monument for corner and accessories established to perpetuate locating the position of the corner:

I-12, T1N, R3E, UNADILLA, left found iron pipe and affixed with 2" dia.
brass disk. Disk stamped "Livingston Co. Monumentation Corner, 19834" and
is accepted as a careful and faithful reestablishment of the position of
the original corner.
350 DEG. 153.31' SET NAIL/TAG W/S 18" OAK.
275 DEG. 148.75' SET NAIL/TAG N/S 16" OAK.
182 DEG. 119.28' SET NAIL/TAG E/S 22" PINE.
149 DEG. 93.79' SET NAIL/TAG NW/S QUAD 12" CHERRY.

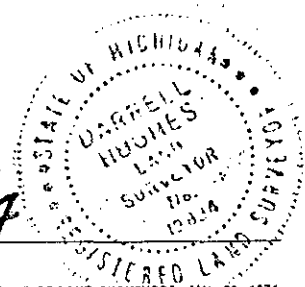

Signed by Darrell Hughes

Date 11-8-94

Surveyor's Michigan License No. 19834

FORM APPROVED BY MICHIGAN STATE BOARD OF LAND SURVEYORS, JAN. 28, 1971
REVISED MAY 14, 1975
REVISED JAN., 1983

PA. 348 1880, APPROVED BY LIVINGSTON COUNTY
PEER GROUP ON 17 Aug 94 CO. REP R.H.L.

I-12, EAST 1/4 COR. 34 & WEST 1/4 COR. 35, T1N, R3E, UNADILLA TWP.

FOUND 3/4" IRON PIPE IN N/S FENCE LINE, SET BY WILSON/ECKFELD P.14.
WITNESS' CHECK.

1825 Sylvester Sibley, Deputy U.S. Surveyor, set 1/4 post 40 chains from south. P.7

1874 Miles Bullock performs survey in Northwest 1/4 of Section 35. Measures West line of Section as 79.67 chains.(5258.22') 1/2 mile as 2629.11' P.8

1938 Clay Gordon notes P.9, used by Wilson to reconstruct corner P.10

1987 Boss (Matt Brady) surveys in section 34 and 35, does not use or reestablish corner. East line of Sec. 34 straight line from I-11 to I-13 measures 5243.14' P.9A

1988 Wilson reconstructs corner, from Clay Gordon notes, sets pipe and witness'. P.10, files Act 74 (Eckfeld) * see page 2 of Act 74 for detail of how set. 5239.37' I-11 to I-13. P.11

1989 Wilson/Eckfeld use corner. Measure 2610.47' south to I-13. P.13

1990 Wilson/Eckfeld measure north to I-11 2628.90' P.14

Good location for GPS.