

**LAND CORNER RECORDATION CERTIFICATE**  
**Filing Requirement of Act 74, Mich. P.A. 1970**

6

**FILED**

**DEC 27 12 22 PM '93**  
 NANCY HAWLAND  
 REGISTER OF DEEDS  
 LIVINGSTON COUNTY, MI  
 48843

L.S.C. #118m  
 Register of Deeds Stamp & File Number

For corners in

|  |                         |               |
|--|-------------------------|---------------|
| <u>Livingston</u><br><small>(County)</small> | Located In:             | Corner Code # |
| 1. Public Land Survey                        | T <u>1N</u> R <u>3E</u> | <u>J-13</u>   |
|  | T _____ R _____         | _____         |
|  | T _____ R _____         | _____         |
|  | T _____ R _____         | _____         |
| 2. Property Controlling<br>in Section        | S _____ T _____ R _____ | _____         |
|  | S _____ T _____ R _____ | _____         |
| 3. Miscellaneous<br>Property in Sec.         | S _____ T _____ R _____ | _____         |
|  | S _____ T _____ R _____ | _____         |

4. Lot No. \_\_\_\_\_, Recorded Plat \_\_\_\_\_  
 5. Private Claims \_\_\_\_\_

I, Darrell D. Hughes, in a field survey on December 15, 19 93, do hereby certify that under requirements of P.A. 74, Michigan P.A. of 1970, the corner points mentioned in lines 1 and 2 above were in conformance with regulations and rules therefore as required in the current manual of survey instructions of the United States Department of the Interior, Bureau of Land Management or by a decree of a Court of Law and/or that the corner points mentioned in lines 3, 4 and 5 above were in conformance with the rules of the Michigan Board of Land Surveyors or by a Decree of a Court of Law; established, re-established, monumented, re-monumented, recovered, found as expressed below:

**NOTE: Not more than 4 corners, all in the same town and range, may be recorded on this certificate.**

A. Description of original monument and accessories and/or subsequent restoration:  
 GLO: 1825  
 Black oak 15" N71.5W 151ks.  
 Black oak 17" N0.5E 42.5 lks.

|    |    |   |    |   |    |   |    |   |    |   |    |   |   |
|----|----|---|----|---|----|---|----|---|----|---|----|---|---|
|    | A  | B | C  | D | E  | F | G  | H | I  | J | K  | L | M |
| 2  | 6  |   | 5  |   | 4  |   | 3  |   | 2  |   | 1  |   |   |
| 3  |    |   |    |   |    |   |    |   |    |   |    |   |   |
| 4  | 7  |   | 8  |   | 9  |   | 10 |   | 11 |   | 12 |   |   |
| 5  |    |   |    |   |    |   |    |   |    |   |    |   |   |
| 6  | 18 |   | 17 |   | 16 |   | 15 |   | 14 |   | 13 |   |   |
| 7  |    |   |    |   |    |   |    |   |    |   |    |   |   |
| 8  | 19 |   | 20 |   | 21 |   | 22 |   | 23 |   | 24 |   |   |
| 9  |    |   |    |   |    |   |    |   |    |   |    |   |   |
| 10 | 30 |   | 29 |   | 28 |   | 27 |   | 26 |   | 25 |   |   |
| 11 |    |   |    |   |    |   |    |   |    |   |    |   |   |
| 12 | 31 |   | 32 |   | 33 |   | 34 |   | 35 |   | 36 |   |   |
| 13 |    |   |    |   |    |   |    |   |    |   |    |   |   |


SURVEY &  
 REMONUMENTATION  
 1993  
 COMMISSION

\* Additional historical information on back of sheet:

B. Description of corner evidence found and/or method applied in restoring or reestablishing corner:  
 Fd. 1-1/2" iron pipe with plastic plug: No. 12029

C. Description of monument for corner and accessories established to perpetuate locating the position of the corner:  
 J-13, T1N, R3E, UNADILLA, left existing 1-1/2" X 30" pipe in place, removed plastic plug #12024 and affixed with 2" dia. brass cap, stamped "Livingston Co. Monumentation Corner, P.S. 19834, and is accepted as a careful and faithful reestablishment of the position of the original corner.  
 RESIDENCE TO N. AND OPEN FIELD TO S.  
 270 DEG. 402.80' TO FD. 2" IRON PIPE IN CEMETERY, FOR NW COR. SEC. 2, T1S, R3E, LYNDON TWP., WASHTENAW CO.  
 237 DEG. 83.99' SET NAIL/TAG SE/S 12" OAK.  
 266 DEG. 94.39' NE UPPER COR. 6" X 35" "TROMBLEY" TOMBSTONE.  
 270 DEG. 106.68' SET NAIL/TAG N/S 22" CHERRY.  
 340 DEG. 3.56' SET NAIL/TAG W/S 6" WHITE PINE.  
 069 DEG. 8.01' SET NAIL/TAG SE/S 8" WHITE PINE.

Signed by Darrell D. Hughes Date December 27, 1993  
 Surveyor's Michigan License No. 19834

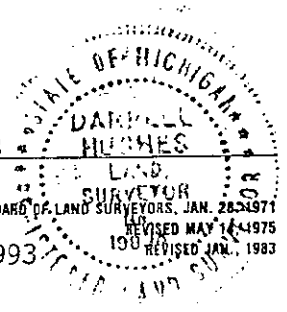

Approved by Liv. Co. Peer Group: Nov. 03, 1993

UNADILLA TOWNSHIP, TOWN 1 NORTH, RANGE 3 EAST

J-13, SOUTH 1/4 CORNER, SECTION 35

FIELD 10-20-93

Found 1-1/2" iron pipe with plastic plug no. 12029, Dwayne Scott, at grade. In East and West fence line, 70'+/- East of East line "Unadilla Baseline Cemetery". 403' +/- East of found 3/4" pipe (inside cemetery) for Northeast corner Section 3, T1S, R3E, Lyndon Twp., Washtenaw Co.

Corner first set by Sylvester Sibley in 1825.

1922, Grant Dunning, ".....ran the South line(section 35) and found it to be 5274 feet, set iron rod half way."  
Corner shown to be 121.5' East of cemetery.

1966, Lyle Munsell, shows cemetery extension and corner 71.42' East of East line cemetery.(as measured today)

1986, Charles Wilson, used corner in survey and shows witness' which we found and checked.

corner is under pines and obscured from sky. access to corner is from cemetery.

1110