

LAND CORNER RECORDATION CERTIFICATE
Filing Requirement of Act 74, Mich. P.A. 1970

For corners in

Livingston
(County)

Located In:

Corner Code ##

- | | | | | | |
|------------------------------------|---|-----------|---|-----------|-------------|
| 1. Public Land Survey | T | <u>1N</u> | R | <u>3E</u> | <u>K-13</u> |
| | T | _____ | R | _____ | _____ |
| | T | _____ | R | _____ | _____ |
| | T | _____ | R | _____ | _____ |
| 2. Property Controlling in Section | S | _____ | T | _____ | R |
| | S | _____ | T | _____ | R |
| 3. Miscellaneous Property in Sec. | S | _____ | T | _____ | R |
| | S | _____ | T | _____ | R |
4. Lot No. _____, Recorded Plat _____
5. Private Claims _____

DEC 27 12 22 PM '93
 NANCY HAVILAND
 REGISTER OF DEEDS
 LIVINGSTON COUNTY, MI
 48843

FILED

L.S.C. #119m
 Register of Deeds Stamp & File Number

A	B	C	D	E	F	G	H	I	J	K	L	M
2	6	5	4	3	2	1						
3												
4	7	8	9	10	11	12						
5												
6	18	17	16	15	14	13						
7												
8	19	20	21	22	23	24						
9												
10	30	29	28	27	26	25						
11												
12	31	32	33	34	35	36						
13												

I, Darrell D. Hughes, in a field survey on December 15, 19 93, do hereby certify that under requirements of P.A. 74, Michigan P.A. of 1970, the corner points mentioned in lines 1 and 2 above were in conformance with regulations and rules therefore as required in the current manual of survey instructions of the United States Department of the Interior, Bureau of Land Management or by a decree of a Court of Law and/or that the corner points mentioned in lines 3, 4 and 5 above were in conformance with the rules of the Michigan Board of Land Surveyors or by a Decree of a Court of Law; established, re-established, monumented, re-monumented, recovered, found as expressed below:

NOTE: Not more than 4 corners, all in the same town and range, may be recorded on this certificate.

A. Description of original monument and accessories and/or subsequent restoration:

GLO: 1825
 Black Oak 11" N30W 60 lks.
 Black Oak 13" N45E 95 lks.

SURVEY &
 REMONUMENTATION
 1993
 COMMISSION

* Additional historical information on back of sheet:

B. Description of corner evidence found and/or method applied in restoring or reestablishing corner:


Fd. 4" diameter concrete monument 6" above grade.

C. Description of monument for corner and accessories established to perpetuate locating the position of the corner:

K-13. T1N, R3E, UNADILLA, left existing conc. monument in place, and is accepted as a careful and faithful reestablishment of the position of the original corner.
 270 DEG. 400.53' FD. CONC. MON. (SET BY DNR) FOR N 1/4 COR. SEC. 2, T1S, R3E, LYNDON TWP., WASHTENAW CO.
 115 DEG. 7.88' SET NAIL/TAG S/S 12" OAK.
 196 DEG. 18.09' SET NAIL/TAG E/S 18" OAK.
 275 DEG. 16.03' SET NAIL/TAG S/S 14" HICKORY.
 028 DEG. 55.81' SET NAIL/TAG W/S TWIN 14" OAK.

Signed by Darrell D. Hughes
 Surveyor's Michigan License No. 19834

Approved by Liv. Co. Peer Group: _____ Date December 27, 1993

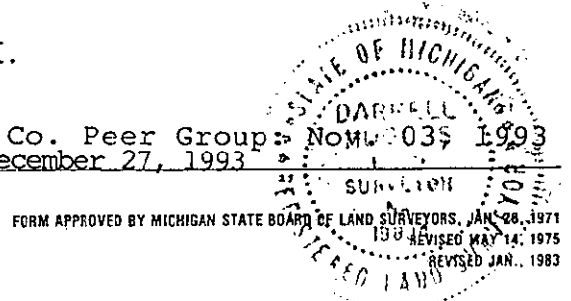

UNADILLA TOWNSHIP, T1N, R3E

K-13, SW CORNER SECTION 36

FIELD 10-20-93

Found 4" dia. concrete monument 6" above grade with 4" dia. aluminum disk on top, stamped: MDNR D.L.B. 18655 8/80, T1N,R3E, SEC.35/36. fence to north and west.

Original corner set by Sylvester Sibley, 1825

1922, Grant Dunning, Survey no. 129, ran south line of section 35, found it to be 5274 feet, set iron rod at 1/2 distance. (2637 feet).

1966, Lyle Munsell, shows S 1/4 cor. to SE cor. sec. 35 to be 2635.25'.

1972, Garlock, shows witness' on CLS no. 533, Liber 614, P.18, " Found remains of cor. post and 1/2" iron rod.

1980, Bissell, RLS 18655 replaced 1/2" iron rod with concrete monument, filed act 74, "...corner has been used previously by Munsell and Garlock."

Witness' by Bissell were imbedded deep in trees, indication but did not dig out, measures check to monument.

Corner is tree covered, access is from State Park, Bruin Lake Campground.