

**LAND CORNER RECORDATION CERTIFICATE**  
 Filing Requirement of Act 74, Mich. P.A. 1970

For corners in  
LIVINGSTON  
 (County)

Located In: Corner Code #  
 1. Public Land Survey T 1N R 3E M-2  
 T     R          
 T     R          
 T     R          
 T     R          
 2. Property Controlling  
 in Section S     T     R          
 S     T     R          
 3. Miscellaneous  
 Property in Sec. S     T     R          
 S     T     R        

4. Lot No. \_\_\_\_\_, Recorded Plat \_\_\_\_\_  
 5. Private Claims \_\_\_\_\_

I, CHARLES E GARLOCK, in a field survey on JULY 15 19 97 do hereby state that under requirements of P.A. 74, Michigan P.A. of 1970, the corner points mentioned in lines 1 and 2 above were in conformance with regulations and rules therefore as required in the current manual of survey instructions of the United States Department of the Interior, Bureau of Land Management or by a decree of a Court of Law and for that the corner points mentioned in lines 3, 4 and 5 above were in conformance with the rules of the Michigan Board of Land Surveyors or by a Decree of a Court of Law, established, re-established, monumented, recovered, found as expressed below.

NOTE: Not more than 2 corners, all in the same town and range, may be recorded on this certificate.

	A	B	C	D	E	F	G	H	I	J	K	L	M
1													
2	6		5		4		3		2		1		
3													
4	7		8		9		10		11		12		
5													
6	18		17		16		15		14		13		
7													
8	19		20		21		22		23		24		
9													
10	30		29		28		27		26		25		
11													
12	31		32		33		34		35		36		
13													

A. Description of original monument and accessories and/or subsequent restoration:  
 GLO SURVEY DATED APRIL 15, 1825 BY S S IBLEY, DS, AND NONE OF THE GLO WITNESSES REMAIN.  
 GLO WITNESSES: BO 21"-S15W-13 LKS  
 WO 14"-N03W-17 LKS

ADDITIONAL DATA ON REAR OF SHEET

B. Description of corner evidence found and/or method applied in restoring or reestablishing corner:  
 FOUND 1/2" I. ROD WITH MY CAP, NO OCCUPATION TO THE WEST, IRON IS 8.93 FEET SOUTH OF THE PUTNAM TWP. CORNER, GLO DISTANCE IS 8.91'

**SURVEY &  
 REMONUMENTATION**


FEB 24 1998

**SECTION**

C. Description of monument for corner and accessories established to perpetuate locating the position of the corner:  
 M-2: E 1/4 COR. SEC. 1 T1N-R3E, UNADILLA TWP. LIV. CO. MI. RESET ABOVE POINT WITH 1 1/4" X 36" BREAKWAY I. PIPE WITH LIV. CO. REMON. BRASS CAP ON TOP, AT -0.6'  
 N13W-69.43'-SP & TAG E/S 5" CHERRY  
 N8W-105.77'-SP & TAG E/S 24" OAK  
 N20E-56.55'-SP & TAG W/S 24" OAK  
 S63E-23.20'-SP & TAG SW/S 36" OAK  
 EAST-1.0'-C/L DUTCHER ROAD  
 NORTH-8.93'-~~N~~ COR. SEC. ~~6~~ PUTNAM TWP.

Signed by Charles E. Garlock  
 Surveyor's Michigan License No. 14762

Date JULY 15, 1997

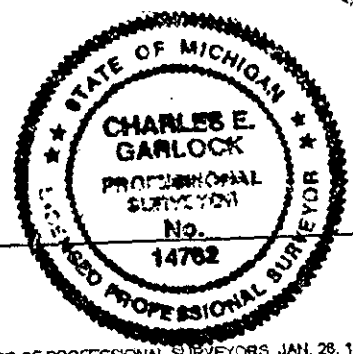

**P.A. 345 1980, APPROVED BY LIVINGSTON COUNTY**  
 PEER GROUP ON 4/2/97 CO. REP JED

**FILED**

REC'D JUL 24 P 1:04  
 NANCY HAVILAND  
 REGISTER OF DEEDS  
 LIVINGSTON COUNTY, MI.  
 48843

L. S. C. #674m

Register of Deeds Stamp & File Number

CORNER SUMMARY

M-2: E 1/4 COR. SEC. 1, T1N-R3E, UNADILLA TWP. LIV. CO. MI

GLO SURVEY DATED 4/15/1825 BY S SIBLEY AND NONE OF THE GLO. WITNESSES REMAIN.



PREVIOUS SURVEYS IN THIS AREA WERE TIED TO EITHER THE WEST 1/4 CORNER OF SECTION 6 PUTNAM TWP. OR THE TOWNSHIP CORNER TO THE NORTH. IN 1992 I SET A 1/2" X 18" I. ROD W/CAP ON LINE WITH THE TOWNSHIP CORNER TO THE NORTH (NE COR. SEC. 1 UNADILLA) AND THE WEST 1/4 CORNER OF SECTION 6 PUTNAM TOWNSHIP AT THE COMPUTED GLO JOG OF 8.91 FEET SOUTH OF THE WEST 1/4 CORNER OF SAID SECTION X PUTNAM TOWNSHIP. THIS YEAR WE FOUND THE 1992 SET IRON ROD AT 8.93 FEET SOUTH OF THE PUTNAM 1/4 CORNER AT -0.2' IN THE GRAVEL OF DUTCHER ROAD, 1992 WITNESSES CHECKED. MEASURED SOUTH 2698.78 FEET TO M-3 AND NORTH 2353.96 TO M-1, JACK ALBRIGHT MEASURED NORTH FROM W 1/4 COR. SEC. 6 2344.68 TO THE TWP. CORNER, ADD 8.93 FEET AND HIS TOTAL FROM M-2 TO M-1 IS 2353.61 FEET. FOUND NO OTHER MEASURES OR SURVEYS BY OTHERS. SITE IS GOOD FOR GPS. RECOMMEND WE CONTINUE TO USE M-2 AS WE FOUND IT AND SET OUR STANDARD REMON PIPE AND CAP.

CHARLES E GARLOCK, PS

FILED

IN 3E M-2