

LAND CORNER RECORDATION CERTIFICATE
Filing Requirement of Act 74, Mich. P.A. 1970

For corners in
LIVINGSTON
(County)

Located In:	Corner Code #
T1N R3E	M-3
T R	
T R	
T R	
T R	
S T R	
S T R	
S T R	
S T R	

1. Public Land Survey

2. Property Controlling
In Section

3. Miscellaneous
Property in Sec.

4. Lot No. _____, Recorded Plat _____

5. Private Claims _____

FILED

NANCY HAVILAND
REGISTER OF DEEDS
LIVINGSTON COUNTY, MI.
48843

1997 JUL 24 P 1:04

L.S.C.#675m

Register of Deeds Stamp & File Number

I, CHARLES E GARLOCK, in a field survey on JULY 15, 1997 do hereby state that under requirements of P.A. 74, Michigan P.A. of 1970, the corner points mentioned in lines 1 and 2 above were in conformance with regulations and rules therefore as required in the current manual of survey instructions of the United States Department of the Interior, Bureau of Land Management or by a decree of a Court of Law and for that the corner points mentioned in lines 3, 4 and 5 above were in conformance with the rules of the Michigan Board of Land Surveyors or by a Decree of a Court of Law; established, re-established, monumented, recovered, found as expressed below:

NOTE: Not more than 2 corners, all in the same town and range, may be recorded on this certificate.

	A	B	C	D	E	F	G	H	I	J	K	L	M
1													
2	6		5		4		3		2		1		
3													
4	7		8		9		10		11		12		
5													
6	18		17		16		15		14		13		
7													
8	19		20		21		22		23		24		
9													
10	30		29		28		27		26		25		
11													
12	31		32		33		34		35		36		
13													

A. Description of original monument and accessories and/or subsequent restoration:
GLO SURVEY DATED APRIL 15, 1825 BY S SIBLEY, DS, AND NONE OF THE GLO WITNESSES REMAIN.
GLO WITNESSES: WO 14"-S53W-14 LKS
WO 14"-N2 1/2W-30 LKS

ADDITIONAL DATA ON REAR OF SHEET


B. Description of corner evidence found and/or method applied in restoring or reestablishing corner:
NO IRON FOUND, BUT FOUND WHAT APPEARS TO BE M W BULLOCK'S 1877 WITNESS TREES AND SET TEMP. IRON FOR CORNER.

**SURVEY &
REMONUMENTATION**

FEB 24 1998

SECTION

C. Description of monument for corner and accessories established to perpetuate locating the position of the corner:
M-3: SE COR. SEC. 1 T1N-R3E UNADILLA TWP. LIV. CO. MI; RESET ABOVE TEMP. IRON WITH 1 1/4" X 36" I. PIPE AT +0.5' WITH LIV. CO. REMON. BRASS CAP ON TOP.
N14W-12.47'-SP & TAG E/S 7" ASH
N56W-19.94'- SP & TAG NE/S 6" OAK
S14W-39.98'-SP & TAG E/S DBL 10" & 12" ASH
N82E-47.88'-SP & TAG S/S 18" W CHERRY
EAST-11.0'-C/L DITCH
NORTH-28.00'-SW COR. SEC. 6 PUTNAM TWP.
SW-0.35'-CARSONIT POS

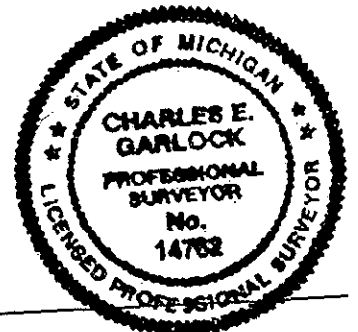

Signed by Charles E. Garlock
Surveyor's Michigan License No. 14762

Date JULY 15, 1997

PA. 348 1980, APPROVED BY LIVINGSTON COUNTY
PEER GROUP ON 4/2/97 CO. REP JED

CORNER SUMMARY

M-3: SE COR. SEC. 1, T1N-R3E, UNADILLA TWP. LIV. CO. MI

GLO SURVEY DATED 4/15/1825 BY S SIBLEY AND NONE OF THE GLO WITNESSES REMAIN.

M BULLOCK WITNESSED THIS CORNER IN 1877 TO A 10" B OAK-S67E-25.08' AND IN 1906 TO A 14" Y OAK-S84 1/2W-49.50'. IN 1992 DURING A SURVEY IN THE NW 1/4 OF SECTION 7 PUTNAM TWP., I FOUND WHAT I BELIEVED TO BE M BULLOCKS TWO WITNESS TREES AND THE MEASURES INTERSECTED ON THE WEST BANK OF THE ANDERSON COUNTY DRAIN 28.00 FEET SOUTH OF THE NW CORNER OF SECTION 7 PUTNAM TWP. WHICH WAS A SET 1/2" I. ROD IN AN OLD FENCE CORNER POST HOLE RUNG WITH STONE AND FENCES TO THE NORTH, EAST AND SOUTH. GLO JOG WAS 17.82 FEET NORTH TO THE PUTNAM CORNER. WE DID NOT FIND ANY FENCE RUNNING TO THE WEST FROM THE POINT OF INTERSECTION OF THE TWO WITNESSES BY M BULLOCK. THIS YEAR WE FOUND THE CORNER I HAD SET FOR PUTNAM TWP. AND M BULLOCKS WITNESSES CROSSED ABOUT 28 FEET SOUTH OF THE PUTNAM TWP. CORNER AS BEFORE, AGAIN MEASURING FROM WHAT IS BELIEVED TO BE M BULLOCKS WITNESS TREES. MEASURES SOUTH ARE 2633.58 FEET BY US AND ANDERSON DRAIN SURVEY HAD 2637.36 FEET IN 1907. MEASURED NORTH 2698.78 FEET TO M-2. NOTE THAT THE MEASURE FROM M-3 SOUTH TO M-5 IS 5280.41 FEET. I RECOMMEND WE SET M-3 AT THIS INTERSECTION OF THE OLD WITNESSES AND SOUTH OF THE PUTNAM TWP. 28.00 FEET. AREA IS WOODED AND NOT GOOD FOR A GPS STATION.



CHARLES E GARLOCK, PS
UAN97M3

Info

1N3E
M-3
4