

LAND CORNER RECORDATION CERTIFICATE
Filing Requirement of Act 74, Mich. P.A. 1970

For corners in

LIVINGSTON
 (County)

Located In:

Corner Code #

- | | | |
|------------------------------------|---------------------------|------------|
| 1. Public Land Survey | T <u>1</u> N R <u>3</u> E | <u>M-5</u> |
| | T___ R___ | _____ |
| | T___ R___ | _____ |
| | T___ R___ | _____ |
| 2. Property Controlling in Section | S___ T___ R___ | _____ |
| | S___ T___ R___ | _____ |
| 3. Miscellaneous Property in Sec. | S___ T___ R___ | _____ |
| | S___ T___ R___ | _____ |

1997 JUL 24 P 1:04
 NANCY HAVILAND
 REGISTER OF DEEDS
 LIVINGSTON COUNTY, MI.
 48843

FILED

L.S.C. #677m

Register of Deeds Stamp & File Number

4. Lot No. _____, Recorded Plat _____
 5. Private Claims _____

I, CHARLES E GARLOCK, in a field survey on JULY 15, 1997 do hereby state that under requirements of P.A. 74, Michigan P.A. of 1970, the corner points mentioned in lines 1 and 2 above were in conformance with regulations and rules therefore as required in the current manual of survey instructions of the United States Department of the Interior, Bureau of Land Management or by a decree of a Court of Law and /or that the corner points mentioned in lines 3, 4 and 5 above were in conformance with the rules of the Michigan Board of Land Surveyors or by a Decree of a Court of Law; established, re-established, monumented, recovered, found as expressed below:

NOTE: Not more than 2 corners, all in the same town and range, may be recorded on this certificate.

	A	B	C	D	E	F	G	H	I	J	K	L	M
1													
2		6		5		4		3		2		1	
3													
4		7		8		9		10		11		12	
5													
6		18		17		16		15		14		13	
7													
8		19		20		21		22		23		24	
9													
10		30		29		28		27		26		25	
11													
12		31		32		33		34		35		36	
13													

A. Description of original monument and accessories and/or subsequent restoration:
 GLO SURVEY DATED APRIL 15, 1825 BY S SIBLEY, DS, AND NONE OF THE GLO WITNESSES REMAIN
 GLO WITNESSES: BO 12"-N58E-4.64 CHAINS
 ONLY ONE WITNESS

ADDITIONAL DATA ON REAR OF SHEET


B. Description of corner evidence found and/or method applied in restoring or reestablishing corner:
 FOUND 1/2" I. ROD BENT OVER, OLD REMAINING WITNESSES CHECKED.

SURVEY & REMONUMENTATION

FEB 24 1998

SECTION

C. Description of monument for corner and accessories established to perpetuate locating the position of the corner:
 M-5: SE COR. SEC. 12 T1N-R3E UNADILLA TWP. LIV. CO. MI, RESET FOUND IRON WITH 1 1/4" X 36" BREAKAWAY I. PIPE WITH LIV. CO. REMON BRASS CAP ON TOP AT -0.6'
 S60W-55.10'-SP & TAG NW/S 10" WILLOW
 S15W-32.47'-SP & TAG E/S 10" WOOD POST
 N77E-31.37'-SP & TAG S/S 12" OAK
 N25W-32.64'-SP & TAG SW/S DBL 12" APPLE
 SOUTH-12'-C/L SPEARS ROAD
 SOUTH-7.92'-PUTNAM TWP. COR.

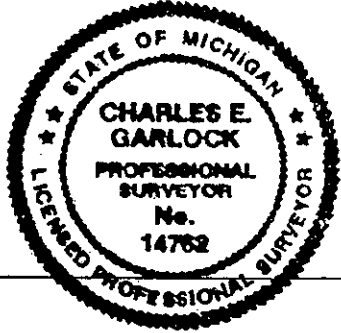

Signed by Charles E. Garlock
 Surveyor's Michigan License No. 14762

Date JULY 15, 1997

CORNER SUMMARY

M-5: SE COR. SEC. 12, T1N-R3E, UNADILLA TWP, LIV. CO. MI

GLO SURVEY DATED 4/15/1825 BY S SIBLEY AND NONE OF THE GLO WITNESSES REMAIN.

IN 1971 MUNSELL-GARLOCK SET A 1/2" I. ROD FOR THIS CORNER WITH NO EXPLANATION AND IN 1974 BENTON USED THIS IRON AS DID N FAHRNER IN 1977, D BISSELL (STATE OF MICHIGAN) IN 1987 AND BOSS ENGR. IN 1989, WE ALSO SET THE PUTNAM CORNER AT THE GLO JOG TO THE SOUTH AT 7.92 FEET. REMAINING WITNESSES OF ALL OF THE ABOVE SURVEYORS CHECK WITH THE FOUND 1/2" I. ROD AND THE PUTNAM TWP. CORNER TO THE SOUTH. DURING REMON WE MEASURED SOUTH 2668.44 FEET AND IN 1972 WE MEASURED SOUTH 2669.11 FEET IN 1972 TO M-6. MEASURES NORTH ARE 2647.06 FEET BY BENTON, 2647.06 BY BOSS, 2647.43 BY D BISSELL AND WE MEASURED 2646.83 FEET TO M-4. THE FOUND PUTNAM CORNER WAS BENT AND MEASURED 0.18 FEET LONGER THAN THE GLO DISTANCE. SITE IS GOOD FOR GPS. WE RECOMMEND CONTINUED USE OF THE CORNER AS FOUND.



CHARLES E. GARLOCK
PS 14762
UNA97M5

M 3 E
M-5
4