

LAND CORNER RECORDATION CERTIFICATE
 Filing Requirement of Act 74, Mich. P.A. 1970

1997 JUL 24 P 1:04
 NANCY HAYLAND
 REGISTER OF DEEDS
 LIVINGSTON COUNTY, MI.
 48843

For corners in
LIVINGSTON
 (County)

Located In: Corner Code #
 T 1N R 3E M-8
 T ___ R ___
 T ___ R ___
 T ___ R ___
 S ___ T ___ R ___
 S ___ T ___ R ___
 S ___ T ___ R ___
 S ___ T ___ R ___

FILED

L.S.C. #680m

Register of Deeds Stamp & File Number

1. Public Land Survey

2. Property Controlling in Section

3. Miscellaneous Property in Sec.

4. Lot No. _____, Recorded Plat _____
 5. Private Claims _____

I, CHARLES E GARLOCK, in a field survey on JULY 14, 1997 do hereby state that under requirements of P.A. 74, Michigan P.A. of 1970, the corner points mentioned in lines 1 and 2 above were in conformance with regulations and rules therefore as required in the current manual of survey instructions of the United States Department of the Interior, Bureau of Land Management or by a decree of a Court of Law and for that the corner points mentioned in lines 3, 4 and 5 above were in conformance with the rules of the Michigan Board of Land Surveyors or by a Decree of a Court of Law, established, re-established, monumented, recovered, found as expressed below:

NOTE: Not more than 2 corners, all in the same town and range, may be recorded on this certificate.

	A	B	C	D	E	F	G	H	I	J	K	L	M
1													
2	6		5		4		3		2		1		
3													
4	7		8		9		10		11		12		
5													
6	18		17		16		15		14		13		
7													
8	19		20		21		22		23		24		
9													
10	30		29		28		27		26		25		
11													
12	31		32		33		34		35		36		
13													

A. Description of original monument and accessories and/or subsequent restoration:
 GLO SURVEY DATED APRIL 15, 1825 BY S SIBLEY, DS, AND NONE OF THE GLO WITNESSES REMAIN
 GLO WITNESSES: BO 12"-S20W-40 LKS
 BO 20"-N51W-6 1/2 LKS

ADDITIONAL DATE ON REAR OF SHEET


B. Description of corner evidence found and/or method applied in restoring or reestablishing corner:
 DID NOT FIND AN IRON SET BY R JAGOW IN 1978, BUT HIS FIVE WITNESSES FROM THE 1978 ACT 74
 CROSSED IN A TIGHT TRIANGLE AND WE SET A TEMP. 20 COMMON SPIKE AT THE POINTS OF INTER-SECTION.

SURVEY & REMONUMENTATION

FEB 24 1998

SECTION

C. Description of monument for corner and accessories established to perpetuate locating the position of the corner:
 M-8: E 1/4 COR. SEC. 24 T1N-R3E UNADILLA TWP. LIV. CO. MI; RESET SPIKE WITH 1 1/4" X 36"
 I. PIPE AT +0.5' WITH LIV. CO. REMON BRASS CAP ON TOP
 S50W-25.65'-SP & TAG NW/S 8" MAPLE
 S6W-20.15'-SP & TAG E/S 20" OAK
 S9E-47.25'-SP & TAG W/S 18" MAPLE
 S76E-21.39'-SP & TAG N/S 36" FORKEB MAPLE
 SOUTH-0.65'-CARSONITE POST
 COR. ON SOUTH EDGE OF WET AREA.
 PUTNAM TWP. CORNER NOT FOUND

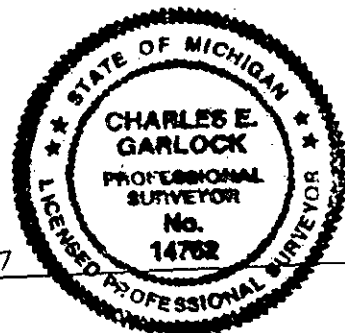

Signed by Charles E. Garlock

Date JULY 14, 1997

P.A. 345 1990, APPROVED BY LIVINGSTON COUNTY
 PEER GROUP ON 6/18/97 CO. REP JED

CORNER SUMMARY

M-8: E 1/4 COR. SEC. 24 T1N-R3E, UNADILLA TWP. LIV. CO. MI

GLO SURVEY DATED APRIL 15, 1825 BY S SIBLEY AND NONE OF THE GLO WITNESSES REMAIN.

R JAGOW IN AUGUST OF 1978 SET A 3/4" I. PIPE ON LINE WITH M-7 AND M-9 AND AT HALF DISTANCE BETWEEN SAME AND RECORDED AN ACT 74. THE 3/4" I. PIPE WE FOUND MATCHED ATWELL-HICKS WITNESSES FROM A 1986 SURVEY AND THIS PIPE WAS LOCATED 3.75 FT. EAST AND 7.02 FT. SOUTH FROM THE WITNESSES R JAGOW HAD ON HIS 1978 ACT 74, JAGOW'S 1978 I. PIPE WAS GONE. IT APPEARS THAT IN A LATER SURVEY BY ATWELL-HICKS THEY SET M-7 TO THE NORTH AT A POINT OTHER THAN R JAGOW'S RECORDED M-7 AND THEN SET A NEW M-8 ON LINE WITH M-9 TO THE SOUTH (WHERE R JAGOW HAD M-9) AND M-7 TO THE NORTH WHERE THEY HAD RELOCATED R JAGOWS M-7 AND AT HALF DISTANCE, THIS BEING THE IRON PIPE WE FOUND. WE FOUND THAT THE JAGOW IRON PIPE IN 1978 WAS ON LINE WITH M-9 TO THE SOUTH (A POINT JAGOW FOUND MATCHED GLO WITNESSES THAT REMAINED AND A TIE WITH A SWAMP) AND M-7 TO THE NORTH THAT MATCHED A FOUND IRON SET/FOUND BY H HAMILL IN 1948. JAGOWS 1978 SET IRON (NOW GONE) WAS ALSO AT HALF DISTANCE BETWEEN THE OLDER M-7 TO THE NORTH AND M-9 TO THE SOUTH. WE RECOMMEND RESETTING AN IRON PIPE AT A POINT THAT MATCHES JAGOWS 1978 ACT 74. OUR MEASURE TO THE SOUTH WOULD BE S00°37'06"W 2652.85 FT. AND N00°37'34"E 2652.53 FT. TO M-7 (HAMILLS M-7). THE PUTNAM CORNER AS SET BY THE LATER ATWELL-HICKS SURVEY SHOULD BE VOIDED AND RESET ON THE TOWNSHIP LINE AS PER GLO COMPUTED JOG.

CHARLES E GARLOCK
PS 14762
UNA97M8

1/3E
M-8
4