

**LAND CORNER RECORDATION CERTIFICATE**  
**Filing Requirement of Act 74, Mich. P.A. 1970**

91

For corners in

LIVINGSTON  
 (County)

Located In:

Corner Code #

- |                                    |                           |            |
|------------------------------------|---------------------------|------------|
| 1. Public Land Survey              | T <u>1</u> N R <u>3</u> E | <u>M-9</u> |
|                                    | T ___ R ___               | _____      |
|                                    | T ___ R ___               | _____      |
|                                    | T ___ R ___               | _____      |
| 2. Property Controlling in Section | S ___ T ___ R ___         | _____      |
|                                    | S ___ T ___ R ___         | _____      |
| 3. Miscellaneous Property in Sec.  | S ___ T ___ R ___         | _____      |
|                                    | S ___ T ___ R ___         | _____      |

**FILED**

NANCY HAVILAND  
 REGISTER OF DEEDS  
 LIVINGSTON COUNTY, MI.  
 48843

1997 JUL 24 P 1:04

L.S.C. #681m

Register of Deeds Stamp & File Number

4. Lot No. \_\_\_\_\_, Recorded Plat \_\_\_\_\_  
 5. Private Claims \_\_\_\_\_

I, CHARLES E GARLOCK, in a field survey on JULY 14, 1997 do hereby state that under requirements of P.A. 74, Michigan P.A. of 1970, the corner points mentioned in lines 1 and 2 above were in conformance with regulations and rules therefore as required in the current manual of survey instructions of the United States Department of the Interior, Bureau of Land Management or by a decree of a Court of Law and /or that the corner points mentioned in lines 3, 4 and 5 above were in conformance with the rules of the Michigan Board of Land Surveyors or by a Decree of a Court of Law; established, re-established, monumented, recovered, found as expressed below:

NOTE: Not more than 2 corners, all in the same town and range, may be recorded on this certificate.

A	B	C	D	E	F	G	H	I	J	K	L	M
1												
2	6		5		4		3		2		1	
3												
4	7		8		9		10		11		12	
5												
6	10		17		16		15		14		13	
7												
8	19		20		21		22		23		24	
9												
10	30		29		28		27		26		25	
11												
12	31		32		33		34		35		36	
13												

- A. Description of original monument and accessories and/or subsequent restoration:  
 GLO SURVEY DATED APRIL 15, 1825 BY S SIBLEY AND NONE OF GLO WITNESSES REMAIN  
 GLO WITNESSES: BO 14"-N09W-7 LKS  
 BO 9"-S25W-25 LKS

ADDITIONAL DATA ON REAR OF SHEET

- B. Description of corner evidence found and/or method applied in restoring or reestablishing corner:


FOUND 3/4" I. PIPE WITH CAP # 6998, R JAGOW SR. FROM 1978 SURVEY WHEN HE FOUND GLO STAKE AND GLO WITNESS TREES THAT MATCHED.

**SURVEY &  
 REMONUMENTATION**

FEB 24 1998

**SECTION**

- C. Description of monument for corner and accessories established to perpetuate locating the position of the corner:  
 M-9: SE COR. SEC. 24 T1N-R3E, UNADILLA TWP. LIV. CO. MI; RESET POINT WITH 1 1/4" X 36" I. PIPE WITH LIV. CO. REMON BRASS CAP ON TOP, AT +0.3'  
 SOUTH-5.12'-SP & TAG W/S 18" OAK  
 N45W-18.67'-SP & TAG S/S 16" CHERRY  
 N15W-13.36'-SP & TAG E/S 12" MAPLE  
 N59E-28.45'-SP & TAG SE/S 18" OAK  
 N71E-30.37'-SP & TAG SE/S 16" OAK  
 SOUTH-0.5'-CARSONITE MARKER  
 NORTH-25.74'-PUTNAM TWP. CORNER

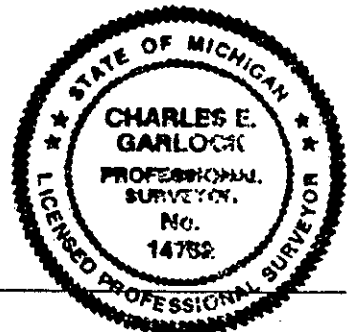

Signed by Charles E. Garlock  
 Surveyor's Michigan License No. 14762

Date JULY 14, 1997

**CORNER SUMMARY**

M-9: SE COR. SEC. 24, T1N-R3E, UNADILLA TWP. LIV. CO., MICH.

GLO SURVEY DATED 4/15/1825 BY S SIBLEY AND GLO WITNESS REMAINS WERE FOUND AS LATE AS 1978 BY ROBERT JAGOW SR.

IN 1978 SURVEY BY R JAGOW SR., HE STATED ON AN ACT 74 "FOUND REMAINS OF ORIGINAL WOODEN STAKE AND WITNESSES AFTER MEASURING 2 CHAINS SOUTH OF SWAMP AS CALLED FOR IN THE ORIGINAL GOVERNMENT NOTES, SET 3/4" X 18" IRON PIPE"; IN 1979 P BENTON USED THE SAME POINT AND HIS WITNESSES CHECK AS DID C WILSON'S WITNESSES IN 1987. WE FOUND A 3/4" I. PIPE WITH CAP NO. 6998 (R JAGOW SR.) FLUSH WITH THE GROUND ABOUT 12 FT. SOUTHERLY OF A 2 TRACK TRAIL ON U OF M LANDS AND ABOUT 10 FT. ABOVE SAID SWAMP. ATWELL-HICKS MEASURED SOUTH 2677.64 FT AND WE HAD 2677.96 FT. ATWELL-HICKS MEASURED NORTH 2645.67 FT. AND WE HAD 2645.84 FT. SITE IS NOT GOOD FOR GPS. BECAUSE 2 GLO WITNESS TREE REMAINS CHECKED WITH THE 2 CHAIN DISTANCE FROM THE SWAMP, I WOULD RECOMMEND WE SET A REMON PIPE AND CAP AT ROBERT JAGOWS RECOVERY POINT OF M-9.



CHARLES E. GARLOCK  
PS 14762  
UNA96M9

T1N R3E  
M-9  
4