

**LAND CORNER RECORDATION CERTIFICATE**  
Filing Requirement of Act 74, Mich. P.A. 1970

For corners in

Livingston  
(County)

Located In:

Corner Code #

- |                                    |                          |             |
|------------------------------------|--------------------------|-------------|
| 1. Public Land Survey              | T <u>1N</u> R <u>3E'</u> | <u>M-10</u> |
|                                    | T _____ R _____          | _____       |
|                                    | T _____ R _____          | _____       |
|                                    | T _____ R _____          | _____       |
| 2. Property Controlling in Section | S _____ T _____ R _____  | _____       |
|                                    | S _____ T _____ R _____  | _____       |
| 3. Miscellaneous Property in Sec.  | S _____ T _____ R _____  | _____       |
|                                    | S _____ T _____ R _____  | _____       |

**FILED**

NANCY HAVILL AND  
REGISTER OF DEEDS  
LIVINGSTON COUNTY, MI.  
48843

1997 JUL 24 P 1:04

L. S. C. #682m

Register of Deeds Stamp & File Number

4. Lot No. \_\_\_\_\_, Recorded Plat \_\_\_\_\_  
5. Private Claims \_\_\_\_\_

I, CHARLES E. GARLOCK, in a field survey on JULY 14, 1997 do hereby state that under requirements of P.A. 74, Michigan P.A. of 1970, the corner points mentioned in lines 1 and 2 above were in conformance with regulations and rules therefore as required in the current manual of survey instructions of the United States Department of the Interior, Bureau of Land Management or by a decree of a Court of Law and /or that the corner points mentioned in lines 3, 4 and 5 above were in conformance with the rules of the Michigan Board of Land Surveyors or by a Decree of a Court of Law; established, re-established, monumented, recovered, found as expressed below.

NOTE: Not more than 2 corners, all in the same town and range, may be recorded on this certificate.

	A	B	C	D	E	F	G	H	I	J	K	L	M
1													
2		6		5		4		3		2		1	
3													
4		7		8		9		10		11		12	
5													
6		16		17		16		15		14		13	
7													
8		19		20		21		22		23		24	
9													
10		30		29		28		27		26		25	
11													
12		31		32		33		34		35		36	
13													

- A. Description of original monument and accessories and/or subsequent restoration:  
GLO SURVEY DATED APRIL 15, 1825 BY S SIBLEY, DS, AND NONE OF THE GLO WITNESSES REMAIN  
GLO WITNESSES: BO 18-S60W-196 LKS  
BO 27-N 1 1/2W-70 LKS

ADDITIONAL HISTORICAL DATA ON REAR OF SHEET

- B. Description of corner evidence found and/or method applied in restoring or reestablishing corner:  
FOUND 3/4" I. PIPE WITH CAP # 13204, CC WILSON PS

**SURVEY &  
REMONUMENTATION**


FEB 24 1998

SECTION

- C. Description of monument for corner and accessories established to perpetuate locating the position of the corner:  
M-10: E 1/4 CORNER SEC. 25, T1N-R3E, UNADILLA TWP. LIV. CO. MI; SET 1 1/4" X 36" I. PIPE WITH LIV. CO. REMON BRASS CAP ON TOP AT +0.5'  
S15E-9.93'-SP & TAG W/S 18" OAK  
N22E-8.96'-SP & TAG W/S 18" FORKED OAK  
N87W-39.67'-SP & TAG N/S 10" WALNUT  
S66W-27.75'-SP & TAG N/S 8" OAK  
NORTH-25.64'-PUTNAM TWP. COR.  
NORTH-55.69'-C/L OF DOYLE ROAD

Signed by Charles E. Garlock  
Surveyor's Michigan License No. 14762


Date JULY 14, 1997

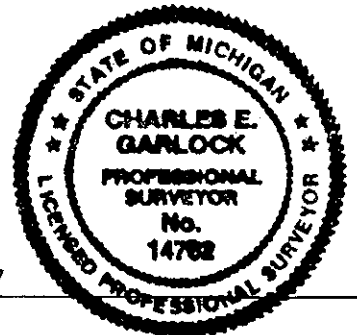

**CORNER SUMMARY**

M-10: E 1/4 CORNER SEC. 25 T1N-R3E, UNADILLA TWP. LIV. CO. MI.  
GLO SURVEY DATED 4/15/1825 BY S SIBLEY AND NONE OF A GLO WITNESSES  
REMAIN.

FOUND NO WITNESSES IN THE OLD COUNTY SURVEY RECORDS BUT IN 1899 M  
BULLOCK WITNESSED THE PUTNAM CORNER AND STATED M-10 WAS 25.74 FEET  
SOUTH. WE FOUND A 1/2" I. PIPE IN A NORTH-SOUTH FENCE LINE THAT WAS  
25.64 FEET SOUTH OF AN IRON ATWELL-HICKS WAS USING FOR THE PUTNAM  
CORNER AND AN IRON WASHTENAW ENGR WAS USING FOR THE PUTNAM CORNER  
THAT WAS 25.72 FEET NORTH OF M-10. WITNESSES BY WASHTENAW ENGR-'72,  
ATWELL-HICKS-'86, BENTON-DATE ?, WILSON-'96 AND BOSS-'91 CHECKED TO  
THE FOUND 1/2" I. PIPE. IN THE NORTH-SOUTH FENCE LINE. IN 1929 C  
GORDON STATED IN FIELD NOTES THAT THE PUTNAM CORNER WAS 25.7 FEET  
NORTH OF M-10 AND THAT THE CENTERLINE OF DOYLE ROAD WAS 30 FEET NORTH  
OF THE PUTNAM CORNER. WE FOUND A 3/4" I. PIPE ON THE CENTERLINE OF  
DOYLE ROAD 30.05 FEET NORTH OF THE PUTNAM CORNER (WASHTENAW ENGR).  
BOSS ENGR MEASURED SOUTH 2633.33 FEET TO THE SE OF SEC. 25 (M-11) AND  
ATWELL-HICKS MEASURED NORTH 2677.64 FEET TO THE NE CORNER SEC. 25.  
SITE IS NOT GOOD FOR GPS. WE DO NOT, AS YET, HAVE COMPARISON  
MEASURES NORTH FROM M-10 TO M-9 BECAUSE IT IS WITHIN THE FENCED AREA  
OF U OF M PROPERTY AND THE TRAILS ARE TOO MUDDY TO TRAVEL. BUT IT  
SEEMS WITH THE INFORMATION BY M BULLOCK, C GORDON AND THE MORE RECENT  
SURVEYORS ALL USING WHAT APPEARS TO BE THE SAME CORNER I WOULD  
RECOMMEND M-10 TO BE THE 1/2" I. PIPE THAT WE HAVE FOUND.

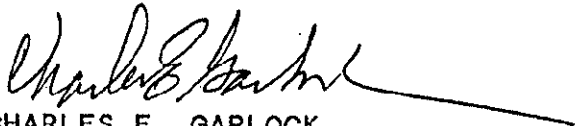  
CHARLES E. GARLOCK  
PS 147623  
UNA97M10

NOTE: APRIL 9, 1997 WE MEASURED NORTH FROM M-10 TO M-9 AND HAD 2677.96 COMPARED TO  
ATWELL-HICKS PREVIOUS MEASURE OF 2677.64

M-10  
4