

SURVEY & REMONUMENTATION

FILED

APR 28 1995

LAND CORNER RECORDATION CERTIFICATE

Nov 16 2 00 PM '94

Filing Requirement of Act 74, Mich. P.A. 1970


NANCY HAVILAND
REGISTER OF DEEDS
LIVINGSTON COUNTY, MI
48843

For corners in **COMMISSION**

<u>LIVINGSTON</u> (County)	Located In:	Corner Code #/
1. Public Land Survey	T <u>1N</u> R <u>4E</u>	<u>E-11</u>
	T _____ R _____	_____
	T _____ R _____	_____
	T _____ R _____	_____
2. Property Controlling in Section	S _____ T _____ R _____	_____
	S _____ T _____ R _____	_____
3. Miscellaneous Property In Sec.	S _____ T _____ R _____	_____
	S _____ T _____ R _____	_____

L.S.C. #344m
Register of Deeds Stamp & File Number

- 4. Lot No. _____, Recorded Plat _____
- 5. Private Claims _____

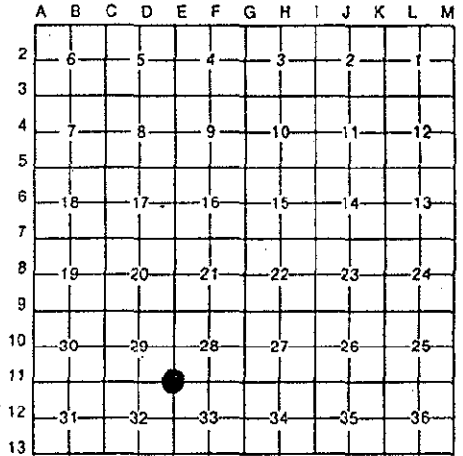

I, DARRELL HUGHES, in a field survey on NOVEMBER 3, 1994, do hereby certify that under requirements of P.A. 74, Michigan P.A. of 1970, the corner points mentioned in lines 1 and 2 above were in conformance with regulations and rules therefore as required in the current manual of survey instructions of the United States Department of the Interior, Bureau of Land Management or by a decree of a Court of Law and/or that the corner points mentioned in lines 3, 4 and 5 above were in conformance with the rules of the Michigan Board of Land Surveyors or by a Decree of a Court of Law; established, re-established, monumented, re-monumented, recovered, found as expressed below:

NOTE: Not more than 4 corners, all in the same town and range, may be recorded on this certificate.

A. Description of original monument and accessories and/or subsequent restoration:
GLO: 1823 Joseph Wampler, Deputy Surveyor
Corner is 'in lake'

*Additional historical information on back of sheet

B. Description of corner evidence found and/or method applied in restoring or reestablishing corner:

Corner not found. Falls in lake. Set accessory point on E-12/E-11 line at centerline of Patterson Lake Road as established and identified in C.L.S. #446, Liber 608, Pages 412-413.


From accessory point North 00 degrees 08 minutes 55 seconds West 1274.26 ft. to E-11
South 00 degrees 08 minutes 55 seconds East 1357.57 ft. to E-12

C. Description of monument for corner and accessories established to perpetuate locating the position of the corner:

E-11, T1N, R4E, PUTNAM, Corner not set, accessory point set. Set 1" X 36" Witness pipe, affixed with 2" dia. brass cap, stamped "Livingston Co. Witness Corner", in road box.
207 DEG. 115.87' SET NAIL/TAG E/S 27" OAK.
161 DEG. 70.50' SET NAIL/TAG W/S 36" ASH.
305 DEG. 34.08' SET NAIL/TAG SW/S 26" OAK.
275 DEG. 66.32' SET NAIL/TAG SW/S 22" OAK.

Signed by *Darrell Hughes* Date 11-8-94

Surveyor's Michigan License No. 19834

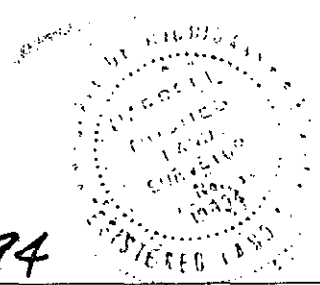

FORM APPROVED BY MICHIGAN STATE BOARD OF LAND SURVEYORS, JAN. 28, 1971
REVISED MAY 14, 1975
REVISED JAN., 1983

P.A. 345 1990, APPROVED BY LIVINGSTON COUNTY
PEER GROUP ON 5 Oct. 94 CO. REP. *Ralph*

E-12, 1/4 CORNER BETWEEN SECTIONS 32 AND 33

FIELD: 09-02-1994

Found 1/2" iron rod at East line "Hi-Land Lake Sub.", 2.30' North of Northeast corner lot 110, now northerly end of Bluebird Road 50 ft. wd. (Public). 12' East of centerline N/S Road "Bluebird", 85' East of East edge lake (name unknown, Mill Pond?) Witness' check with Garlock and Atwell-Hicks (H. Taft). OK for GPS.

1823 Corner first set by Joseph Wampler, U.S. Deputy Surveyor. (P.7)

1869 Miles Bullock surveys SW1/4 Sec. 33, fd. post. (P.8)

1925 "Hi-Land Lake" subdivision Platted by Grant Dunning. Sets iron rod "1/2" X 18", or more" at corner. (P.9-9A)

1961 Lyle Munsell witness' (P. 13)

1972 Howard Taft finds corner, shows witness', files Act 74 (P.17-18)

1973 William Lincoln uses corner in survey. (P.19)

1987 Hughes finds corner and uses in survey. (P.20-21)

1990 Mary Barnwell uses corner in survey, shows witness' by Taft. (P.22)

1993 Garlock files Act 74 (P.24)