

SURVEY & REMONUMENTATION

OCT 21 1999

FILED

Nov 16 2 00 PM '94

LAND CORNER RECORDATION CERTIFICATE
Filing Requirement of Act 74, Mich. P.A. 1970

SECTION

For corners in

NANCY HAVILAND
REGISTER OF DEEDS
LIVINGSTON COUNTY, MI
48843

LIVINGSTON
(County)

Located In: _____ Corner Code ##

1. Public Land Survey T 1N R 4E E-12
T _____ R _____
T _____ R _____
T _____ R _____

2. Property Controlling S _____ T _____ R _____
in Section S _____ T _____ R _____

3. Miscellaneous S _____ T _____ R _____
Property in Sec. S _____ T _____ R _____

4. Lot No. _____, Recorded Plat _____

5. Private Claims _____

L.S.C.#345m
Register of Deeds Stamp & File Number

	A	B	C	D	E	F	G	H	I	J	K	L	M
2	6		5		4		3		2		1		
3													
4	7		8		9		10		11		12		
5													
6	18		17		16		15		14		13		
7													
8	19		20		21		22		23		24		
9													
10	30		29		28		27		26		25		
11													
12	31		32		33		34		35		36		
13													

I, DARRELL HUGHES, in a field survey on NOVEMBER 3, 1994, do hereby certify that under requirements of P.A. 74, Michigan P.A. of 1970, the corner points mentioned in lines 1 and 2 above were in conformance with regulations and rules therefore as required in the current manual of survey instructions of the United States Department of the Interior, Bureau of Land Management or by a decree of a Court of Law and/or that the corner points mentioned in lines 3, 4 and 5 above were in conformance with the rules of the Michigan Board of Land Surveyors or by a Decree of a Court of Law; established, re-established, monumented, re-monumented, recovered, found as expressed below:

NOTE: Not more than 4 corners, all in the same town and range, may be recorded on this certificate.

PUTNAM TWP.

A. Description of original monument and accessories and/or subsequent restoration:

GLO: 1823 Joseph Wampler, Deputy Surveyor
White Oak 10" South 45 degrees West 20 links
White Oak 9" South 79 degrees East 31 links

*Additional historical information on back of sheet

B. Description of corner evidence found and/or method applied in restoring or reestablishing corner:


Fd. 1/2" iron rod at East line "Hi-Land Lake Sub.", 2.30 ft. North of NE corner Lot 110

C. Description of monument for corner and accessories established to perpetuate locating the position of the corner:

E-12, T1N, R4E, PUTNAM, replaced existing corner with 1-1/4" X 36" iron pipe, affixed with 2" dia. brass cap, stamped "Livingston Co. Monumentation Corner", 19834, and is accepted as a careful and faithful reestablishment of the position of the original corner.
350 DEG. 20.44' SET NAIL/TAG E/S 20" OAK.
035 DEG. 24.25' SET NAIL/TAG SE/S UTILITY POLE.
109 DEG. 34.32' SET NAIL/TAG N/S 18" OAK.
214 DEG. 38.65' SET NAIL/TAG NW/S 14" OAK.
270 DEG. 85' SHORE OF LAKE.

Signed by Darrell Hughes Date 11-8-94

Surveyor's Michigan License No. 19834

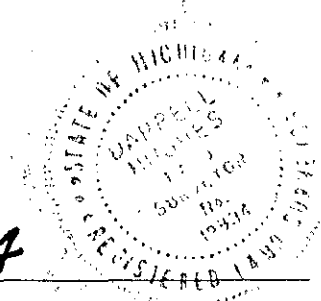

FORM APPROVED BY MICHIGAN STATE BOARD OF LAND SURVEYORS, JAN. 28, 1971
REVISED MAY 14, 1975
REVISED JAN., 1983

PA. 345 1990, APPROVED BY LIVINGSTON COUNTY
PEER GROUP ON 28 Sep 94 CO. REP [Signature]