

**SURVEY & REMONUMENTATION**

FEB 25 1999

SECTION

**LAND CORNER RECORDATION CERTIFICATE**  
Filing Requirement of Act 74, Mich. P.A. 1970

**FILED**

For corners in

LIVINGSTON  
(County)

Located In:

Corner Code #

**T1N R4E**

~~T1N R5E~~

G-07

T \_\_\_ R \_\_\_

T \_\_\_ R \_\_\_

T \_\_\_ R \_\_\_

§ \_\_\_ T \_\_\_ R \_\_\_

§ \_\_\_ T \_\_\_ R \_\_\_

§ \_\_\_ T \_\_\_ R \_\_\_

§ \_\_\_ T \_\_\_ R \_\_\_

1. Public Land Survey

2. Property Controlling in Section

3. Miscellaneous

Property in Sec.

4. Lot No. \_\_\_\_\_, Recorded Plat. \_\_\_\_\_

5. Private Claims \_\_\_\_\_

1998 OCT 14 P 2:10

9-  
NANCY HAVILAND  
REGISTER OF DEEDS  
LIVINGSTON COUNTY, MI.  
48843

SC 901M

Register of Deeds Stamp & File Number

I, JACK K. SMITH, in a field survey on SEPTEMBER 17, 1998, do hereby state that under requirements of P.A. 74, Michigan P.A. of 1970, the corner points mentioned in lines 1 and 2 above were in conformance with regulations and rules therefore as required in the current manual of survey instructions of the United States Department of the Interior, Bureau of Land Management or by a decree of a Court of law and/or that the corner points mentioned in lines 3, 4 and 5 above were in conformance with the rules of the Michigan Board of Land Surveyors or by a Decree of a Court of Law, established, re-established, monumented, recovered, found as expressed below:

NOTE: Not more than 2 corners, all in the same town and range, may be recorded on this certificate.

|    | A | B  | C | D  | E | F  | G | H  | I | J  | K | L  | M |
|----|---|----|---|----|---|----|---|----|---|----|---|----|---|
| 1  |   |    |   |    |   |    |   |    |   |    |   |    |   |
| 2  |   | 6  |   | 5  |   | 4  |   | 3  |   | 2  |   | 1  |   |
| 3  |   |    |   |    |   |    |   |    |   |    |   |    |   |
| 4  |   | 7  |   | 8  |   | 9  |   | 10 |   | 11 |   | 12 |   |
| 5  |   |    |   |    |   |    |   |    |   |    |   |    |   |
| 6  |   | 18 |   | 17 |   | 16 |   | 15 |   | 14 |   | 13 |   |
| 7  |   |    |   |    |   |    |   |    |   |    |   |    |   |
| 8  |   | 19 |   | 20 |   | 21 |   | 22 |   | 23 |   | 24 |   |
| 9  |   |    |   |    |   |    |   |    |   |    |   |    |   |
| 10 |   | 30 |   | 29 |   | 28 |   | 27 |   | 26 |   | 25 |   |
| 11 |   |    |   |    |   |    |   |    |   |    |   |    |   |
| 12 |   | 31 |   | 32 |   | 33 |   | 34 |   | 35 |   | 36 |   |
| 13 |   |    |   |    |   |    |   |    |   |    |   |    |   |

A. Description of original monument and accessories and/or subsequent restoration:

GLO 1815 WAMPLER SET POST  
WHITE OAK 15 N46W 46 (30.4)  
HICKORY 3 N47E 23 (15.2)

B. Description of corner evidence found and/or method applied in restoring or reestablishing corner:

FOUND A 1/2" REROD INSIDE 1" PIPE ON THE CENTER LINE OF CEDAR LAKE ROAD (GRAVEL) WITH FENCES TO THE EAST AND WEST. THIS CORNER POSITION AGREES WELL WITH WITNESSES OF RECORD SINCE 1966.

C. Description of monument for corner and accessories established to perpetuate locating the position of the corner:


G-07 CORNER COMMON TO SECTIONS 15, 16, 21 AND 22, T1N, R4E, PUTNAM TOWNSHIP, LIVINGSTON COUNTY, MICHIGAN:  
SET 1 1/4" X 6" BREAK AWAY STEEL PIPE ON EXISTING 1" STEEL PIPE WITH LIVINGSTON COUNTY REMONUMENTATION BRASS CAP WITH SURVEYOR #35999 @ 1/2 FOOT BELOW THE SURFACE OF CEDAR LAKE ROAD.

EAST CENTER OF NORTHERLY STEEL CORNER POST 33.16'  
S15°W NAIL WITH LIVINGSTON COUNTY REMON TAG IN EAST SIDE 40" OAK 175.45'  
S85°W NAIL WITH LIVINGSTON COUNTY REMON TAG IN S. SIDE 20" OAK S'LY OF 5 55.48'  
S70°W NAIL WITH LIVINGSTON COUNTY REMON TAG IN N. SIDE 7" WILD CHERRY 30.26'

Signed by [Signature]

Date 9-25-1998

Surveyor's Michigan license No. 35999

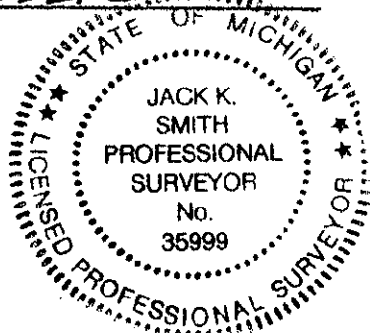

FORM APPROVED BY MICHIGAN STATE BOARD OF PROFESSIONAL SURVEYORS, J.  
REVISED MAY 14, 1975 REVISED JAN, 1983  
REVISED OCT, 1993

PA. 348 1980, APPROVED BY LIVINGSTON COUNTY  
PEER GROUP ON 9-16-98, CO. REP JEP