

SURVEY & REMONUMENTATION

FEB 25 1999

FILED

SECTION

LAND CORNER RECORDATION CERTIFICATE
Filing Requirement of Act 74, Mich. P.A. 1970

For corners in

LIVINGSTON
(County)

located in:

Corner Code #

T1N R4E

~~T1N R5E~~

G-08

1. Public land survey

T ___ R ___

T ___ R ___

T ___ R ___

2. Property Controlling
in section

§ ___ T ___ R ___

§ ___ T ___ R ___

3. Miscellaneous
Property in sec.

§ ___ T ___ R ___

§ ___ T ___ R ___

4. Lot No. _____, Recorded Plat. _____

5. Private Claims _____

1998 OCT 14 P 2: 10

NANCY HAVILAND
REGISTER OF DEEDS
LIVINGSTON COUNTY, MI.
48843

LSC (11) 902M

Register of Deeds Stamp & File Number

I, JACK K. SMITH, in a field survey on SEPTEMBER 17, 1998, do hereby state that under requirements of D.A. 74, Michigan D.A. of 1970, the corner points mentioned in lines 1 and 2 above were in conformance with regulations and rules therefore as required in the current manual of survey instructions of the United States Department of the Interior, Bureau of Land Management, or by a decree of a Court of law and/or that the corner points mentioned in lines 3, 4 and 5 above were in conformance with the rules of the Michigan Board of Land Surveyors or by a Decree of a Court of law, established, re-established, monumented, recovered, found as expressed below:

NOTE: Not more than 2 corners, all in the same town and range, may be recorded on this certificate.

	A	B	C	D	E	F	G	H	I	J	K	L	M
1													
2		6		5		4		3		2		1	
3													
4		7		8		9		10		11		12	
5													
6		16		17		18		15		14		13	
7													
8		19		20		21		22		23		24	
9													
10		30		29		28		27		26		25	
11													
12		31		32		33		34		35		36	
13													

A. Description of original monument and accessories and/or subsequent restoration:

GLO 1815 WAMPLER SET POST
WHITE OAK 4 N35W 42 (27.7)
HICKORY 4 S31E 66 (43.6)

B. Description of corner evidence found and/or method applied in restoring or reestablishing corner:

FOUND A 1/2" REROD 6 FEET WESTERLY OF THE CENTER LINE OF CEDAR LAKE ROAD (GRAVEL) AND APPROXIMATELY 160.5 FEET SOUTHERLY OF THE CENTER LINE OF RAILS TO TRAILS PROPERTY. THIS CORNER POSITION AGREES WELL WITH WITNESSES OF RECORD SINCE 1971 (POSSIBLY 1952).


C. Description of monument for corner and accessories established to perpetuate locating the position of the corner:

G-08 WEST 1/4 CORNER SECTION 22 / EAST 1/4 CORNER SECTION 21, T1N, R4E, PUTNAM TOWNSHIP, LIVINGSTON COUNTY, MICHIGAN:
RESET FOUND 1/2" REROD WITH 1 1/4" X 36" STEEL PIPE WITH LIVINGSTON COUNTY REMONUMENTATION BRASS CAP WITH SURVEYOR #35999 @ 1/2 FOOT BELOW THE SURFACE OF CEDAR LAKE ROAD.

N75°W SOUTHEAST CORNER OF HOUSE # 9490 61.87'
S65°W NAIL WITH LIVINGSTON COUNTY REMON TAG IN SOUTH SIDE 18" OAK 49.03'
S40°E NAIL WITH LIVINGSTON COUNTY REMON TAG IN NORTH SIDE UTIL. POLE 55.48'
S40°W NAIL WITH LIVINGSTON COUNTY REMON TAG IN SE SIDE 20" OAK 69.47'

Signed by [Signature] OF MICHIGAN Date 9-25-1998

Surveyor's Michigan license No. 35999

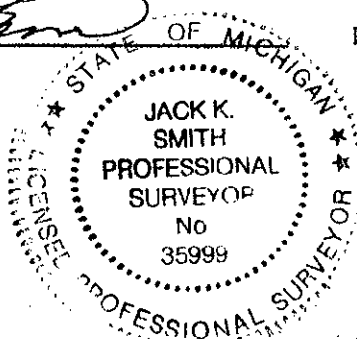

FORM APPROVED BY MICHIGAN STATE BOARD OF PROFESSIONAL SURVEYORS, J.
REVISED MAY 14, 1975 REVISED JAN, 1983
REVISED OCT., 1995

P.A. 345 1990, APPROVED BY LIVINGSTON COUNTY
PEER GROUP ON 9-16-98, CO. REP JED