

FILED

9

Oct 16 11 43 AM '95

LAND CORNER RECORDATION CERTIFICATE
Filing Requirement of Act 74, Mich. P.A. 1970

NANCY HAVILAND
REGISTER OF DEEDS
LIVINGSTON COUNTY, MI
48843

or corners in

<u>LIVINGSTON</u> <small>(County)</small>	Located In:	Corner Code #
Public Land Survey	T <u>1N</u> R <u>4E</u>	<u>G-9</u>
	T _____ R _____	_____
	T _____ R _____	_____
	T _____ R _____	_____
Property Controlling in Section	S _____ T _____ R _____	_____
Miscellaneous Property in Sec.	S _____ T _____ R _____	_____

L.S.C.# 496m

Register of Deeds Stamp & File Number

Lot No. _____, Recorded Plat _____
Private Claims _____

DARRELL HUGHES, in a field survey on OCT. 4 ~~JANUARY 23~~, 19 95,
I hereby certify that under requirements of P.A. 74, Michigan P.A. of 1970, the corner points mentioned
in lines 1 and 2 above were in conformance with regulations and rules therefore as required in the
current manual of survey instructions of the United States Department of the Interior, Bureau of Land
Management or by a decree of a Court of Law and/or that the corner points mentioned in lines 3, 4 and 5
above were in conformance with the rules of the Michigan Board of Land Surveyors or by a Decree of a
Court of Law, established, re-established, monumented, re-monumented, recovered, found as
expressed below:

A	B	C	D	E	F	G	H	I	J	K	L	M
2	6	5	4	3	2	1						
3												
4	7	8	9	10	11	12						
5												
6	18	17	16	15	14	13						
7												
8	19	20	21	22	23	24						
9												
10	30	29	28	27	26	25						
11												
12	31	32	33	34	35	36						
13												

NOTE: Not more than 4 corners, all in the same town and range, may be recorded on this certificate.


Description of original monument and accessories and/or subsequent restoration:
GLO: 1823 Joseph Wampler, Deputy Surveyor
Hickory 4" North 77 degrees West 111 links
White Oak 23" South 71 degrees East 116 links

PUTNAM TWP.
SURVEY &
REMONUMENTATION
NOV 27 1995
COMMISSION

Description of corner evidence found and/or method applied in restoring or reestablishing corner:
Found 1-1/4" iron pipe

*Additional descriptions and historical information on back of this sheet.

Description of monument for corner and accessories established to perpetuate locating the position of the corner:
G-9, T1N, R4E, PUTNAM, replaced existing corner with 1-1/4" X 36" iron pipe, affixed with 2" dia. brass cap, stamped "Livingston Co. Monumentation Corner, P.S. 19834, and is accepted as a careful and faithful reestablishment of the position of the original corner.
260 DEG. 3.26' FD. 3/4" IRON ROD.
153 DEG. 10.28' FD. 3/4" IRON ROD.
218 DEG. 52.52' SET NAIL/TAG SE/S 10" WHITE OAK.
016 DEG. 107.53' SET NAIL/TAG W/S 20" OAK.
087 DEG. 80.07' SET NAIL/TAG S/S 30" OAK.
148 DEG. 63.09' SET NAIL/TAG NE/S UTILITY POLE.
276 DEG. 33.03' FD. 1/2" IRON ROD/CAP #17640.

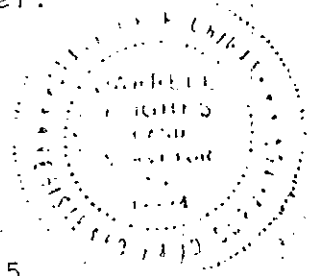

Signed by Darrell Hughes Date October 5, 1995
Surveyor's Michigan License No. 19834

PUTNAM TOWNSHIP, T1N, R4E

G-9, CORNER COMMON TO SECTIONS 21, 22, 27 AND 28.

FIELD: JANUARY 1995

FOUND THREE IRONS (HEREAFTER REFERRED TO AS POINTS 50, 51 AND 52) WITHIN A 12' DIAMETER CIRCLE NEAR THE INTERSECTION OF CEDAR LAKE ROAD AND MOWER ROAD. (AT THIS TIME, I'D WISH TO INTERJECT THAT TWO IRONS WERE FOUND, 5' APART (EAST AND WEST, POINTS 56 AND 55) FOR G-10, 1/2 MILE SOUTH) NOW, POINT 50 IS A 1-1/4" IRON PIPE SET BY CHARLES WILSON IN 1971 FROM EVIDENCE FROM THE FORD MOTOR CO. SURVEY (1941 ?) FOR THE PINCKNEY DAM SITE. SURVEYORS WHO HAVE USED THIS POINT ARE WILSON, YOUNG, BOSS, ROSS AND GARLOCK AS SHOWN BY THEIR MEASURES AND WITNESS'. IT FALLS 2' WEST OF THE CL CEDAR LK. RD. AND 7' NORTH OF CL MOWER ROAD AND 3.2' EAST OF POINT 52. POINT 52 IS A 3/4" IRON ROD THAT WAS IN EXISTENCE BEFORE POINT 51 WAS SET. I BELIEVE MINSSELL SET THIS IRON 1336' WEST OF AN 1/8 LINE FENCE RUNNING NORTH FROM MOWER ROAD, SO IT WOULD AGREE WITH THE DISTANCE FROM H-9 WEST TO THE SAME 1/8 LINE FENCE, WHICH WHEN DOUBLED, AGREES WITH THE DISTANCE FROM I-9 TO H-9. (SEE PAGE 12) IT HAS BEEN USED BY MINSSELL, GARLOCK AND PERHAPS BOSS WHEN THEY PLATTED "FAIRWOOD". (SEE PAGE 20) POINT 50 IS A 3/4" IRON ROD 11' +/- SSE OF POINTS 51 AND 52. IT FALLS CLOSE TO THE ROAD CENTERLINES INTERSECTION. (SEE PAGE 23C) THERE IS NO EVIDENCE OF ANYONE USING THIS IRON. CURIOUSLY, IT IS THE PROJECTION OF G-11 (POINT 58) THRU POINT 56. POINT 56 IS THE EASTERLY PINCH IRON PIPE OF TWO IRONS FOUND AT G-10), CREATING POINT 56 AS 1/2 DISTANCE AND ON LINE. (SEE PAGE 23B) I RECOMMEND THE ACCEPTANCE OF POINT 51 (1-1/4" IRON PIPE) SET BY WILSON. THIS POINT HAS BEEN USED BY MOST SURVEYORS OF RECENT. HOWEVER, REMEMBER, PERHAPS SOMEWHERE BURIED NEAR ALL THIS MESS IS AN "IRON AND GRINDSTONE" SET BY ISAAC TELLER IN 1888. (SEE P.9)

- 1823 Corner first set by Joseph Wampler, U.S. Deputy Surveyor....."North between Sec. 27 and 28, 80.00 chains, set corner common to 21, 22, 27 and 28". P.7
- 1838 Richard Peterson Jr., deputy county surveyor, to Amos Adams, uses corner in survey. P.8
- 1888 Isaac Teller..."stake a iron and a grind stone" P.9
- 1870-1913 county surveyor corner witness book. P.10-10A
- 1935 L.A. Smith, PE survey shows corner. P.11
- 1965 Lyle Munsell shows corner 8' west of centerline Cedar Lake Road. P.12
- 1971 Charles Wilson sets 1" iron pipe and files Act 74. P.13
- 1972 Charles Garlock shows 1" iron pipe. P.14
- 1973 Oscar Boss finds and uses 1" iron pipe. P.15
- 1973 Charles Garlock shows 3/4" iron rod, 8' west of centerline and files Act 74. P. 16-16A
- 1977 Charles Garlock copies Wilson's Act 74 witness' for 1" pipe. P.17
- 1979 George Young accepts Wilson pipe and files Act 74 with some new witness'. finds and shows iron rod 10.28' southerly (point 50), does not show point 52. P.19-19B
- 1980 Gary Boss plats "Fairwood". no distances to G-9, however bearings show they may have used 3/4" iron rod (point 52). P. 20
- 1990 Don Ross uses 1" iron pipe in survey and copies Boss 1973 survey witness'. P.21-21B
- 1995 Hughes witness comparisons, trav., sketches etc. P.22-23E