

SURVEY & REMONUMENTATION

LAND CORNER RECORDATION CERTIFICATE

APR 28 1995 Filing Requirement of Act 74, Mich. P.A. 1970

FILED

NOV 16 2 00 PM '94
 NANCY HAVILAND
 REGISTER OF DEEDS
 LIVINGSTON COUNTY, MI
 48843

corners in

LIVINGSTON
 (County)

COMMISSION

Corner Code ##

Public Land Survey

T 1N R 4E

G-11

T _____ R _____

T _____ R _____

T _____ R _____

Property Controlling
 in Section

S _____ T _____ R _____

Miscellaneous

S _____ T _____ R _____

Property in Sec.

S _____ T _____ R _____

L.S.C.#349m

Register of Deeds Stamp & File Number

Lot No. _____, Recorded Plat _____

Private Claims _____

	A	B	C	D	E	F	G	H	I	J	K	L	M
2	6	5	4	3	2	1							
3													
4	7	8	9	10	11	12							
5													
6	18	17	16	15	14	13							
7													
8	19	20	21	22	23	24							
9													
10	30	29	28	27	26	25							
11													
12	31	32	33	34	35	36							
13													

PUTNAM TWP.

DARRELL HUGHES, in a field survey on NOVEMBER 3, 1994,

hereby certify that under requirements of P.A. 74, Michigan P.A. of 1970, the corner points mentioned lines 1 and 2 above were in conformance with regulations and rules therefore as required in the current manual of survey instructions of the United States Department of the Interior, Bureau of Land Management or by a decree of a Court of Law and/or that the corner points mentioned in lines 3, 4 and 5 above were in conformance with the rules of the Michigan Board of Land Surveyors or by a Decree of a Court of Law; established, re-established, monumented, re-monumented, recovered, found as pressed below:

NOTE: Not more than 4 corners, all in the same town and range, may be recorded on this certificate.

Description of original monument and accessories and/or subsequent restoration:

GLO: 1823 Joseph Wampler, Deputy Surveyor
 White Oak 6" North 73½ degrees West 40 links
 White Oak 26" South 71 degrees East 39 links


*Additional historical information on back of sheet

Description of corner evidence found and/or method applied in restoring or reestablishing corner:

Fd. 1/2" iron rod in asphalt pavement, centerline of Cedar Lake and Patterson Lake Roads

Description of monument for corner and accessories established to perpetuate locating the position of the corner:

G-11, T1N, R4E, PUTNAM, replaced existing corner with 1-1/4" X 36" iron pipe, affixed with 2" dia. brass disk. Disk stamped "Livingston Co. Monumentation Corner, 19834". Corner in road box and is accepted as a careful and faithful reestablishment of the position of the original corner.
 028 DEG. 78.01' SET NAIL/TAG TOP OF WOOD FENCE POST.
 038 DEG. 63.43' SET NAIL/TAG E/S UTILITY POLE.
 075 DEG. 90.76' SET NAIL/TAG S/S WOOD FENCE POST.
 294 DEG. 20.54' SET NAIL/TAG TOP WOOD GUARD RAIL POST.

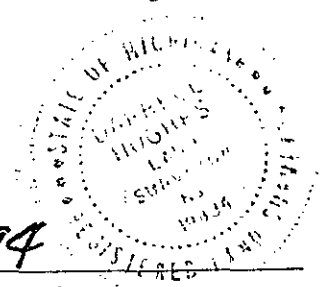

signed by [Signature]

Date 11-8-94

Surveyor's Michigan License No. 19834

FORM APPROVED BY MICHIGAN STATE BOARD OF LAND SURVEYORS, JAN. 28, 1971
 REVISED MAY 14, 1975
 REVISED JAN., 1983

P.A. 345 1980, APPROVED BY LIVINGSTON COUNTY
 PEER GROUP ON CB Sep 94, CO. REP [Signature]

PUTNAM TOWNSHIP, T1N, R4E

G-11, CORNER COMMON TO SECTIONS 28, 27, 33 & 34

FIELD 08-26-1994

Found 1/2" iron rod (unreadable cap) 0.15' below asphalt pavement at centerline of Cedar Lake Road and Patterson Lake Road. Set by Garlock. Witness' check Desine 1992 survey for Liv. Co. Rd. Comm.

- 1823 Corner first set by Joseph Wampler, U.S. Deputy Surveyor. (P.7)
- 1848 E.N.Fairchild, County Surveyor uses corner to break down SW 1/4 Sec. 27. (P.8) Note Bullock comment.
- 1967 Garlock finds 2" iron pipe and witness'. (P.9-10)
- 1972 Taft (Atwell-Hicks) files Act 74. new ties. Found 1-1/4" iron pipe. (P.15)
- 1972 William Lincoln calls for 3/4" iron pipe (P.16)
- 1972 Garlock shows witness' does not identify corner. (P.17)
- 1973 Oscar Boss finds 1" pipe, new witness' (P. 19)
- 1973 Oscar Boss finds 1-1/4" iron, new witness' (P.20)
- 1976 H.Taft, Atwell-Hicks, 1/2" plugged rerod, new ties. (P.23)
- 1976 Robert Campbell, Boss Engineering, finds 1/2" plugged rerod. (P.22)
- 1983 Pat Benton finds capped iron rod.(P.24)
- 1988 Hughes finds 1/2" iron rod shows witness' (P.25)
- 1991 Garlock resets iron rod from proration of Boss and Benton surveys. (P.26-28)
- 1992 Jack Smith (Design) finds 1/2" iron, shows new witness' (P.29)