

SURVEY & REMONUMENTATION

FEB 25 1999

SECTION

LAND CORNER RECORDATION CERTIFICATE
Filing Requirement of Act 74, Mich. P.A. 1970

FILED

For corners in

LIVINGSTON
(County)

Located in:

Corner Code #

T1N R4E

~~T1N R5E~~

107

1. Public Land Survey

T___ R___

T___ R___

T___ R___

2. Property Controlling
in Section

§ T___ R___

§ T___ R___

3. Miscellaneous
Property in Sec.

§ T___ R___

§ T___ R___

1998 OCT 14 P 2:11

NANCY HAVILAND
REGISTER OF DEEDS
LIVINGSTON COUNTY, MI.
48843

9-LSC 904M

Register of Deeds Stamp & File Number

4. Lot No. _____ Recorded Plat _____

5. Private Claims _____

I, JACK K. SMITH, in a field survey on SEPTEMBER 17, 1998 do hereby state that under requirements of D.A. 74, Michigan D.A. of 1970, the corner points mentioned in lines 1 and 2 above were in conformance with regulations and rules therefore as required in the current manual of survey instructions of the United States Department of the Interior, Bureau of Land Management or by a decree of a Court of Law and /or that the corner points mentioned in lines 3, 4 and 5 above were in conformance with the rules of the Michigan Board of Land Surveyors or by a Decree of a Court of Law; established, re-established, monumented, recovered, found as expressed below:

NOTE: Not more than 2 corners, all in the same town and range, may be recorded on this certificate.

	A	B	C	D	E	F	G	H	I	J	K	L	M
1													
2	6		5		4		3		2		1		
3													
4	7		8		9		10		11		12		
5													
6	16		17		16		15		14		13		
7													
8	19		20		21		22		23		24		
9													
10	30		29		28		27		26		25		
11													
12	31		32		33		34		35		36		
13													

A. Description of original monument and accessories and/or subsequent restoration:

GLO 1815 WAMPLER SET POST
WHITE OAK . 18 N15W 206 (136.0')
WHITE OAK . 20 N17E 185 (122.1')

B. Description of corner evidence found and/or method applied in restoring or reestablishing corner:

FOUND A 1/2" REROD WITH BRAD THOMPSON CAP 12 FEET SOUTHERLY OF FENCE LINE.


C. Description of monument for corner and accessories established to perpetuate locating the position of the corner:

I-07 SOUTH 1/4 CORNER SECTION 15 / NORTH 1/4 CORNER SECTION 22, T1N, R4E, PUTNAM TOWNSHIP, LIVINGSTON COUNTY, MICHIGAN:
RESET FOUND 1/2" REROD WITH 1 1/4" X 36" BREAK AWAY STEEL PIPE WITH LIVINGSTON COUNTY REMONUMENTATION BRASS CAP WITH SURVEYOR #35999 @ 1/2 FOOT ABOVE THE SURFACE OF SURROUNDING GROUND WITH CARSONITE MARKER PLACED DIRECTLY TO THE SOUTH.

N05°E	NAIL WITH LIVINGSTON COUNTY REMON TAG IN EAST SIDE 30" OAK	145.65'
N12°W	CENTER OF CONC. FENCE POST BASE 70 FEET EAST OF GALV STEEL COR. POST	12.92'
S55°W	1" X 36" STEEL PIPE WITH LIVINGSTON COUNTY REMON WITNESS CAP	25.00'
WEST	2" DIAMETER GALVANIZED STEEL FENCE CORNER POST	76.90'

Signed by [Signature] Date 9-25-1998

Surveyor's Michigan License No. 35999

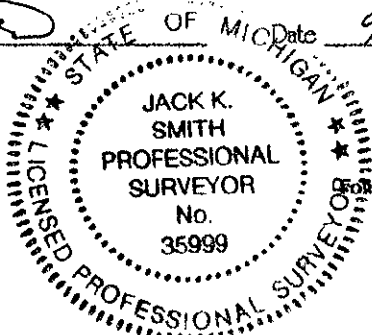

FORM APPROVED BY MICHIGAN STATE BOARD OF PROFESSIONAL SURVEYORS, J.
REVISED MAY 14, 1975 REVISED JAN, 1983
REVISED OCT, 1993

PA. 848 1998, APPROVED BY LIVINGSTON COUNTY
FEEB GROUP ON 9/16/98, CO. REP JED