

LAND CORNER RECORDATION CERTIFICATE
Filing Requirement of Act 74, Mich. P.A. 1970

For corners in

Livingston
(County)

Located In:

Corner Code ##

| | | | | | |
|------------------------------------|---|-----------|---|-----------|-------------|
| 1. Public Land Survey | T | <u>1N</u> | R | <u>4E</u> | <u>I-13</u> |
| | T | _____ | R | _____ | _____ |
| | T | _____ | R | _____ | _____ |
| | T | _____ | R | _____ | _____ |
| 2. Property Controlling in Section | S | _____ | T | _____ | _____ |
| | S | _____ | T | _____ | _____ |
| 3. Miscellaneous Property in Sec. | S | _____ | T | _____ | _____ |
| | S | _____ | T | _____ | _____ |

4. Lot No. _____, Recorded Plat _____
 5. Private Claims _____

HANGY HAVILANG
 REGISTER OF DEEDS
 LIVINGSTON COUNTY, MI
 48843
 Dec 27 12 22 PM '93

FILED

L.S.C. #115 m

Register of Deeds Stamp & File Number

| | A | B | C | D | E | F | G | H | I | J | K | L | M |
|----|----|----|----|----|----|----|---|---|---|---|---|---|---|
| 2 | 6 | 5 | 4 | 3 | 2 | 1 | | | | | | | |
| 3 | | | | | | | | | | | | | |
| 4 | 7 | 8 | 9 | 10 | 11 | 12 | | | | | | | |
| 5 | | | | | | | | | | | | | |
| 6 | 18 | 17 | 16 | 15 | 14 | 13 | | | | | | | |
| 7 | | | | | | | | | | | | | |
| 8 | 19 | 20 | 21 | 22 | 23 | 24 | | | | | | | |
| 9 | | | | | | | | | | | | | |
| 10 | 30 | 29 | 28 | 27 | 26 | 25 | | | | | | | |
| 11 | | | | | | | | | | | | | |
| 12 | 31 | 32 | 33 | 34 | 35 | 36 | | | | | | | |
| 13 | | | | | | | | | | | | | |

I, Darrell D. Hughes, in a field survey on December 16, 19 93, do hereby certify that under requirements of P.A. 74, Michigan P.A. of 1970, the corner points mentioned in lines 1 and 2 above were in conformance with regulations and rules therefore as required in the current manual of survey instructions of the United States Department of the Interior, Bureau of Land Management or by a decree of a Court of Law and/or that the corner points mentioned in lines 3, 4 and 5 above were in conformance with the rules of the Michigan Board of Land Surveyors or by a Decree of a Court of Law; established, re-established, monumented, re-monumented, recovered, found as expressed below:

NOTE: Not more than 4 corners, all in the same town and range, may be recorded on this certificate.

A. Description of original monument and accessories and/or subsequent restoration:

GLO: 1819
 White Oak 24" N9W 17 lks.
 White Oak 38" N53E 27 lks.

* Additional historical information on back of sheet:

B. Description of corner evidence found and/or method applied in restoring or reestablishing corner:

Found "T" iron.

SURVEY &
 REMONUMENTATION


1993

COMMISSION

C. Description of monument for corner and accessories established to perpetuate locating the position of the corner:

I-13. T1N, R4E, PUTNAM, replaced existing corner with 1-1/4" X 36" iron pipe, affixed with 2" dia. brass cap, stamped "Livingston Co. Monumentation Corner, P.S. 19834, and is accepted as a careful and faithful reestablishment of the position of the original corner.
 330 DEG. 7.00' SET NAIL/TAG E/S 6" APPLE.
 022 DEG. 19.59' SET NAIL/TAG SE/S 12" ELM.
 100 DEG. 8.18' SET NAIL/TAG N/S 8" POPLAR.
 160 DEG. 3.83' SET NAIL/TAG NE/S 10" POPLAR.

Signed by Darrell D. Hughes Approved by Liv. Co. Peer Group: _____
 Date December 27, 1993
 Surveyor's Michigan License No. 19834

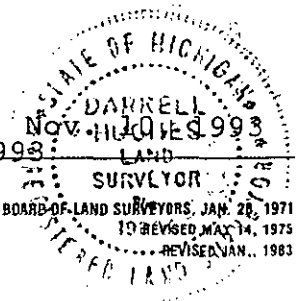

PUTNAM TOWNSHIP, T1N, R4E

I-13, SW CORNER SECTION 35

FIELD 10-21-93

Found "T" iron from witness' stated in Act 74, filed by Gary Boss, 1978. Corner on side slope, west of Toma Road in dense wooded area. 57' west of centerline gravel road and 156 ft. south of centerline Portage River.

Corner first set by Joseph Wampler, 1819 " ...west on the south boundary Section 35, 80.00 chains, set post common to Sec. 34 and 35."

1849, John Mullett, Deputy Surveyor, in a remeasurement of lines between Fletcher Base line of 1816 and Wampler Base line of 1819, shows falling with NE cor. Sec.3 and NW cor. Sec. 2, T1S, Dexter, Washtenaw Co. (I-1) to be 9.23 chains (609.18').

1970, Edwin McCombs, Consumers Power, set "T" iron, 555.23' West of I-1, Dexter.

1971, Gary Stonerock surveyed for Detroit Edison Co., fd. "T" iron for corner.

1977, Boss uses "T" iron and constructs straight line north to East 1/4 corner, I-12.

1978, Boss files Act 74 on corner for survey in SE 1/4 sec. 34. dated Oct. 5, 1977.