

FILED

9

Oct 16 11 43 AM '95

LAND CORNER RECORDATION CERTIFICATE
Filing Requirement of Act 74, Mich. P.A. 1970

HANCY HAVILAND
REGISTER OF DEEDS
LIVINGSTON COUNTY, MI
48843

or corners in

| <u>LIVINGSTON</u> <small>(County)</small> | Located In: | Corner Code # |
|--|-------------------------|---------------|
| Public Land Survey | T <u>1N</u> R <u>4E</u> | <u>J-9</u> |
| | T _____ R _____ | _____ |
| | T _____ R _____ | _____ |
| | T _____ R _____ | _____ |
| Property Controlling in Section | S _____ T _____ R _____ | _____ |
| Miscellaneous Property in Sec. | S _____ T _____ R _____ | _____ |

L.S.C.# 492m

Register of Deeds Stamp & File Number

Lot No. _____, Recorded Plat _____
Private Claims _____

| | A | B | C | D | E | F | G | H | I | J | K | L | M |
|----|----|---|----|---|----|---|----|---|----|---|----|---|---|
| 2 | 6 | | 5 | | 4 | | 3 | | 2 | | 1 | | |
| 3 | | | | | | | | | | | | | |
| 4 | 7 | | 8 | | 9 | | 10 | | 11 | | 12 | | |
| 5 | | | | | | | | | | | | | |
| 6 | 15 | | 17 | | 16 | | 15 | | 14 | | 13 | | |
| 7 | | | | | | | | | | | | | |
| 8 | 19 | | 20 | | 21 | | 22 | | 23 | | 24 | | |
| 9 | | | | | | | | | | | | | |
| 10 | 30 | | 29 | | 28 | | 27 | | 26 | | 25 | | |
| 11 | | | | | | | | | | | | | |
| 12 | 31 | | 32 | | 33 | | 34 | | 35 | | 36 | | |
| 13 | | | | | | | | | | | | | |

PUTNAM TWP.

SURVEY &
REMONUMENTATION

NOV 27 1995

COMMISSION

DARRELL HUGHES, in a field survey on Oct. 4
JANUARY 23, 19 95,
hereby certify that under requirements of P.A. 74, Michigan P.A. of 1970, the corner points mentioned
lines 1, and 2 above were in conformance with regulations and rules therefore as required in the
current manual of survey instructions of the United States Department of the Interior, Bureau of Land
Management or by a decree of a Court of Law and/or that the corner points mentioned in lines 3, 4 and 5
above were in conformance with the rules of the Michigan Board of Land Surveyors or by a Decree of a
Court of Law; established, re-established, monumented, re-monumented, recovered, found as
expressed below:

NOTE: Not more than 4 corners, all in the same town and range, may be recorded
on this certificate.

Description of original monument and accessories and/or subsequent restoration:

GLO: 1823, Joseph Wampler, Deputy Surveyor
White Oak 15", South 46-1/2 degrees West, 29 links
White Oak 12", North 32 degrees East, 127 links


Description of corner evidence found and/or method applied in restoring or reestablishing corner:

Found 1 inch iron pipe with 1/2 inch iron rod inside pipe.

*Additional descriptions and historical information on back of this sheet.

Description of monument for corner and accessories established to perpetuate locating the position of the corner:

J-9, T1N, R4E, PUTNAM, replaced existing corner with 1-1/4" X 36" iron
pipe, affixed with 2" dia. brass cap, all within a road box, cap stamped
"Livingston Co. Monumentation Corner, P.S. 19834, and is accepted as a
careful and faithful reestablishment of the position of the original
corner.
089 DEG. 27.30' SET NAIL/TAG N/S UTILITY POLE.
097 DEG. 32.89' FD. 1/2" IRON ROD/GARLOCK.
166 DEG. 62.28' SET NAIL/TAG W/S 36" OAK.
223 DEG. 58.00' SET NAIL/TAG E/S 30" OAK.
258 DEG. 34.52' SET NAIL/TAG S/S UTILITY POLE.

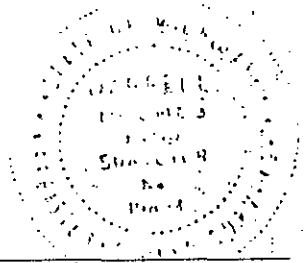

Signed by Darrell Hughes Date October 5, 1995

Surveyor's Michigan License No. 19834

PUTNAM TOWNSHIP, T1N, R4E

J-9, NORTH 1/4 COR. SEC. 26 AND SOUTH 1/4 COR. SEC. 23

FIELD: FEBRUARY 1995

FOUND 1" IRON PIPE, 3 FT. EAST OF CL DEXTER-PINCKNEY ROAD AT ASPHALT GRADE. ALSO FOUND 1/2" IRON ROD IN CENTER OF IRON PIPE. MEASURES FOR 1/2 MILE EAST AND WEST SHOW THAT RECENT SURVEYORS HAVE USED 3/4" IRON PIPE WITH WITNESS' IN AGREEMENT. FOUND 1/2" IRON ROD (GARLOCK) 32.89' EAST OF 3/4" IRON PIPE.

- 1823 Corner first set by Joseph Wampler, U.S. Deputy Surveyor....39.20 chains (2587.20') set 1/4 sec. post. P.7
- 1871 Miles Bullock measures 80.80 chains (5332.80') from J-9 to J-11. Hughes 1995 (5307.46') P.8
- 1915 Grant Dunning shows a measure of 40.11 chains (2647.26') from J-10 to J-9 in 1878. Boss 1994 (2645.73'). P.9
- 1935 L.A. Smith shows corner in survey. J-9 north to centerline M-36 as 1320' P.10
- 1937-1949 Clay Gorden shows older witness' (do not exist now) P.11-14
- 1968 Lyle Munsell shows distance from J-9 north to centerline M-36 as 1317.24' P.15
- 1972 Charles Wilson fills Act 74 "found 1/2" iron pipe" P.16
- 1972 Robert Jagow sets iron pipe for corner in survey. Shows witness' for some other corner. P.17
- 1979-1986-1987 Boss find 1/2" iron. Show Wilson's Act 74 witness'. P.18-19
- 1994 Mary Barnwell finds 3/4" pipe and shows new witness' in survey. P.20-20C
- 1994 Gary Boss finds 3/4" iron pipe show new witness' that agree very close with Barnwell. P.21
- 1995 Hughes field witness' for remon. program. P.22