

LAND CORNER RECORDATION CERTIFICATE
Filing Requirement of Act 74, Mich. P.A. 1970

For corners in

Livingston
 (County)

Located In:

Corner Code =#

- | | | | | | |
|------------------------------------|---|-----------|---|-----------|-------------|
| 1. Public Land Survey | T | <u>1N</u> | R | <u>4E</u> | <u>J-13</u> |
| | T | _____ | R | _____ | _____ |
| | T | _____ | R | _____ | _____ |
| | T | _____ | R | _____ | _____ |
| 2. Property Controlling in Section | S | _____ | T | _____ | _____ |
| | S | _____ | T | _____ | _____ |
| 3. Miscellaneous Property in Sec. | S | _____ | T | _____ | _____ |
| | S | _____ | T | _____ | _____ |

4. Lot No. _____, Recorded Plat _____
 5. Private Claims _____

Dec 27 12 22 PM '93
 NANCY HAVILAND
 REGISTER OF DEEDS
 LIVINGSTON COUNTY, MI
 48843

FILED

L.S.C. #116 m
 Register of Deeds Stamp & File Number

I, Darrell D. Hughes, in a field survey on December 16, 1993, do hereby certify that under requirements of P.A. 74, Michigan P.A. of 1970, the corner points mentioned in lines 1 and 2 above were in conformance with regulations and rules therefore as required in the current manual of survey instructions of the United States Department of the Interior, Bureau of Land Management or by a decree of a Court of Law and/or that the corner points mentioned in lines 3, 4 and 5 above were in conformance with the rules of the Michigan Board of Land Surveyors or by a Decree of a Court of Law; established, re-established, monumented, re-monumented, recovered, found as expressed below:

NOTE: Not more than 4 corners, all in the same town and range, may be recorded on this certificate.

	A	B	C	D	E	F	G	H	I	J	K	L	M
2	6		5		4		3		2		1		
3													
4	7		8		9		10		11		12		
5													
6	18		17		16		15		14		13		
7													
8	19		20		21		22		23		24		
9													
10	30		29		28		27		26		25		
11													
12	31		32		33		34		35		36		
13													

- A. Description of original monument and accessories and/or subsequent restoration:
 GLO: 1819
 Black Oak 16" N72E 34 lks.
 Black Oak 20" N48.5W 67 lks.


* Additional historical information on back of sheet:

- B. Description of corner evidence found and/or method applied in restoring or reestablishing corner:
 Fd. 1-1/2" iron pipe with survey plug: No. 6998.

SUTCLIFF &
 REMONUMENTATION
 1993
 COMMISSION

- C. Description of monument for corner and accessories established to perpetuate locating the position of the corner:
 J-13, T1N, R4E, PUTNAM, replaced existing iron pipe with 1-1/4" X 36" iron pipe, affixed with 2" dia. brass cap, stamped "Livingston Co. Monumentation Corner, P.S. 19834, and is accepted as a careful and faithful reestablishment of the position of the original corner.
 278 DEG. 7.80' SET NAIL/TAG N/S 24" OAK.
 019 DEG. 28.22' SET NAIL/TAG E/S 8" CHERRY.
 120 DEG. 23.80' SET NAIL/TAG NE/S 24" OAK.
 208 DEG. 34.45' SET NAIL/TAG W/S 8" OAK

igned by Darrell D. Hughes Approved by Liv. Co. Peer Group Date December 27, 1993
 Surveyor's Michigan License No. 19834

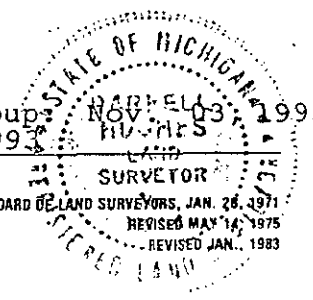

PUTNAM TOWNSHIP, T1N, R4E

J-13, SOUTH 1/4 CORNER SEC. 35

Field 10-21-93

Found 1-1/2" iron pipe with survey plug no. 6998, Robert Jagow. The top of pipe is a threaded union. pipe is at grade. No witness nails found in trees, however tie distances check to tree centerlines. Downed fence wire east, west and north. Corner is on private property owned by Dr. Rudy Reichert. Access is from gravel drive at West side Dexter-Pinckney Road, 400 feet south of Tiplady Rd.

Corner first set by Joseph Wampler, 1819

1961, Lyle Munsell witnessed corner " 3/4" pipe with 1/2" union".

1961, 1966, 1967, 1969, Munsell and Garlock use same corner for surveys in area.

1973, Robert Jagow files Act 74, showing 1961 Munsell witnesses and adds more.

1988, Boss uses corner, job no. 88356.

corner is in wooded tree row (mature oaks) at end of two track drive. 150 feet west of North end of pond, 150 feet southeast of second pond. 50'+/- west of wooden look-out tower. centerline two-track drive 126' north.