

MAR 17 2000

SECTION

LAND CORNER RECORDATION CERTIFICATE
Filing Requirement of Act 74, Mich. P.A. 1970

FILED

For corners in

<u>LIVINGSTON</u> (County)	Located In:	Corner Code #
1. Public Land Survey	<u>T1N R4E</u>	<u>K-02</u>
	T___ R___	_____
	T___ R___	_____
	T___ R___	_____
2. Property Controlling in Section	S___ T___ R___	_____
	S___ T___ R___	_____
3. Miscellaneous Property in Sec.	S___ T___ R___	_____
	S___ T___ R___	_____

1999 JUN -4 P 12: 55
NANCY HAVILAND
REGISTER OF DEEDS
LIVINGSTON COUNTY, MI.
48843


L.S.C. #1026m

Register of Deeds Stamp & File Number

4. Lot No. _____, Recorded Plat _____
5. Private Claims _____

I, JACK K SMITH, in a field survey on MARCH 22, 1999 do hereby state that under requirements of P.A. 74, Michigan P.A. of 1970, the corner points mentioned in lines 1 and 2 above were in conformance with regulations and rules therefore as required in the current manual of survey instructions of the United States Department of the Interior, Bureau of Land Management or by a decree of a Court of Law and /or that the corner points mentioned in lines 3, 4 and 5 above were in conformance with the rules of the Michigan Board of Land Surveyors or by a Decree of a Court of Law; established, re-established, monumented, recovered, found as expressed below:

NOTE: Not more than 2 corners, all in the same town and range, may be recorded on this certificate.

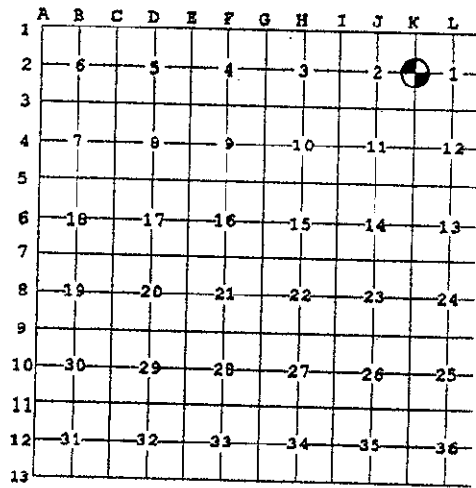

A. Description of original monument and accessories and/or subsequent restoration:

GLO 1825 SIBLEY SET POST
W. OAK 10 N 87 W 32 (21.1')
W. OAK 11 N 76 E 4 (2.6')

B. Description of corner evidence found and/or method applied in restoring or reestablishing corner:

FOUND A 1/2" REROD IN A ROAD BOX ON LINE WITH FENCE TO THE WEST. THIS POSITION AGREES WELL WITH WITNESSES DATING BACK TO 1957 MUNSELL NOTES.

C. Description of monument for corner and accessories established to perpetuate locating the position of the corner:


K-02 WEST 1/4 CORNER SECTION 1 AND EAST 1/4 CORNER SECTION 2, T1N, R4E, PUTNAM TOWNSHIP, LIVINGSTON COUNTY, MICHIGAN:
RESET FOUND 1/2" IRON WITH 1 1/4" X 36" STEEL PIPE WITH BREAKOFF SECTION WITH LIVINGSTON COUNTY REMONUMENTATION BRASS CAP WITH SURVEYOR #35999 @ 1/2 FOOT BELOW THE SURFACE OF BITUMINOUS ROAD IN ROAD BOX ON CENTER LINE OF D-19 (PINCKNEY ROAD).

WEST NAIL WITH LIVINGSTON COUNTY REMON TAG IN NORTH SIDE FENCE POST 33.34'
EAST NAIL WITH LIVINGSTON COUNTY REMON TAG IN SOUTH SIDE UTILITY POLE 208.80'
N65°E NAIL WITH LIVINGSTON COUNTY REMON TAG IN NORTH SIDE 14" CHERRY 86.97'
N36°W NAIL WITH LIVINGSTON COUNTY REMON TAG IN NORTH SIDE DBL. 12" PINE 57.04'

Signed by [Signature]

Date 3-26-1999

Surveyor's Michigan License No. 35999

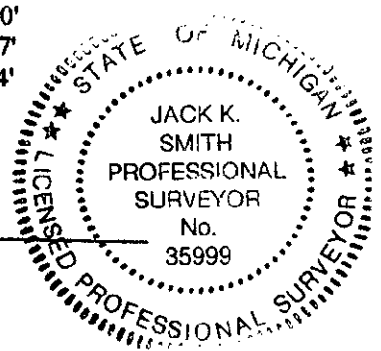

PA. 345 1990, APPROVED BY LIVINGSTON COUNTY
PEER GROUP ON 3-3-1999, CO. REP JED