

MAR 17 2000

SECTION

LAND CORNER RECORDATION CERTIFICATE  
Filing Requirement of Act 74, Mich. P.A. 1970

FILED

For corners in

<u>LIVINGSTON</u> (County)	Located In:	Corner Code #
1. Public Land Survey	<u>T1N R4E</u>	<u>K-05</u>
	T___ R___	_____
	T___ R___	_____
	T___ R___	_____
2. Property Controlling in Section	S___ T___ R___	_____
	S___ T___ R___	_____
3. Miscellaneous Property in Sec.	S___ T___ R___	_____
	S___ T___ R___	_____

1999 JUN -4 P 12: 56

NANCY HAVILAND  
REGISTER OF DEEDS  
LIVINGSTON COUNTY, MI.  
48843

L.S.C. #1029m

Register of Deeds Stamp & File Number

- 4. Lot No. \_\_\_\_\_, Recorded Plat \_\_\_\_\_
- 5. Private Claims \_\_\_\_\_

I, JACK K SMITH, in a field survey on MARCH 22, 1999, do hereby state that under requirements of P.A. 74, Michigan P.A. of 1970, the corner points mentioned in lines 1 and 2 above were in conformance with regulations and rules therefore as required in the current manual of survey instructions of the United States Department of the Interior, Bureau of Land Management or by a decree of a Court of Law and/or that the corner points mentioned in lines 3, 4 and 5 above were in conformance with the rules of the Michigan Board of Land Surveyors or by a Decree of a Court of Law; established, re-established, monumented, recovered, found as expressed below:

NOTE: Not more than 2 corners, all in the same town and range, may be recorded on this certificate.

1	A	B	C	D	E	F	G	H	I	J	K	L	M
2		6		5		4		3		2		1	
3													
4		7		8		9		10		11		12	
5													
6		18		17		16		15		14		13	
7													
8		19		20		21		22		23		24	
9													
10		30		29		28		27		26		25	
11													
12		31		32		33		34		35		36	
13													

A. Description of original monument and accessories and/or subsequent restoration:

GLO 1825 SIBLEY SET POST  
TAM 5 N 6 E 12 (7.9)  
TAM 4 S 56 1/2 W 42 (27.7)


B. Description of corner evidence found and/or method applied in restoring or reestablishing corner:

FOUND A "T" IRON REPORTED AS FOUND BY BOSS IN 1976 IN AN EAST-WEST FENCE LINE. THIS POSITION AGREES WELL WITH THE WITNESSES BOSS REPORTED IN 1976.

C. Description of monument for corner and accessories established to perpetuate locating the position of the corner:

K-05 CORNER COMMON TO SECTION 11, 12, 13 AND 14, T1N, R4E, PUTNAM TOWNSHIP, LIVINGSTON COUNTY, MICHIGAN:  
RESET FOUND "T" IRON WITH 1 1/4" X 36" STEEL PIPE WITH LIVINGSTON COUNTY REMONUMENTATION BRASS CAP WITH SURVEYOR #35999 @ 1/2 FOOT ABOVE THE SURFACE OF SURROUNDING GROUND.

N10°E	NAIL WITH LIVINGSTON COUNTY REMON TAG IN WEST SIDE 10" MAPLE	41.12'
WEST	NAIL WITH LIVINGSTON COUNTY REMON TAG IN NORTH SIDE 10" MAPLE	10.90'
N30°E	NAIL WITH LIVINGSTON COUNTY REMON TAG IN NW. SIDE 8" MAPLE	14.02'
EAST	NAIL WITH LIVINGSTON COUNTY REMON TAG IN SOUTH SIDE 10" MAPLE	30.71'

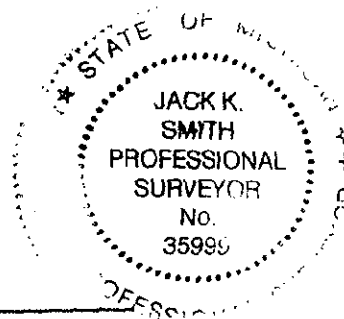

Signed by [Signature]

Date 3-26-1999

Surveyor's Michigan License No. 35999

P.A. 345 1990, APPROVED BY LIVINGSTON COUNTY  
PEER GROUP ON 3-3-1999 CO. REP JED