

FILED

9

LAND CORNER RECORDATION CERTIFICATE  
Filing Requirement of Act 74, Mich. P.A. 1970

OCT 16 11 43 AM '95

HANCOCK HAVILAND  
REGISTER OF DEEDS  
LIVINGSTON COUNTY, MI  
48843

or corners in

<u>LIVINGSTON</u> (County)	Located In:	Corner Code ##
Public Land Survey	T <u>1N</u> R <u>4E</u>	<u>K-9</u>
	T _____ R _____	_____
	T _____ R _____	_____
	T _____ R _____	_____
Property Controlling	S _____ T _____ R _____	_____
in Section	S _____ T _____ R _____	_____
Miscellaneous	S _____ T _____ R _____	_____
Property in Sec.	S _____ T _____ R _____	_____

L.S.C# 493m

Register of Deeds Stamp & File Number

Lot No. \_\_\_\_\_, Recorded Plat \_\_\_\_\_  
Private Claims \_\_\_\_\_

A	B	C	D	E	F	G	H	I	J	K	L	M
2	6	5	4	3	2	1						
3												
4	7	8	9	10	11	12						
5												
6	13	17	16	15	14	13						
7												
8	19	20	21	22	23	24						
9												
10	30	29	28	27	26	25						
11												
12	31	32	33	34	35	36						
13												

PUTNAM TWP.

DARRELL HUGHES, In a field survey on OCT. 4  
JANUARY 23, 1995,  
I hereby certify that under requirements of P.A. 74, Michigan P.A. of 1970, the corner points mentioned  
in lines 1 and 2 above were in conformance with regulations and rules therefore as required in the  
current manual of survey instructions of the United States Department of the Interior, Bureau of Land  
Management or by a decree of a Court of Law and/or that the corner points mentioned in lines 3, 4 and 5  
above were in conformance with the rules of the Michigan Board of Land Surveyors or by a Decree of a  
Court of Law; established, re-established, monumented, re-monumented, recovered, found as  
expressed below:

NOTE: Not more than 4 corners, all in the same town and range, may be recorded  
on this certificate.

Description of original monument and accessories and/or subsequent restoration:  
GLO: 1823, Joseph Wampler, Deputy Surveyor  
Black Oak 3", North 48-1/2 degrees West, 33 links  
Black Oak 16", South 3-1/2 degrees East, 83 links

SURVEY &  
REMONUMENTATION

NOV 27 1995


Description of corner evidence found and/or method applied in restoring or reestablishing corner:  
Found 3/4 inch iron pipe, Cap, No. 6998

COMMISSION

\*Additional descriptions and historical information on back of this sheet.

Description of monument for corner and accessories established to perpetuate locating the position of the corner:

K-9, T1N, R4E, PUTNAM, replaced existing corner with 1-1/4" X 36" iron  
pipe, affixed with 2" dia. brass cap, stamped "Livingston Co.  
Monumentation Corner, P.S. 19834, and is accepted as a careful and  
faithful reestablishment of the position of the original corner.  
058 DEG. 4.63' SET NAIL/TAG NW/S 46" OAK.  
097 DEG. 25.73' SET NAIL/TAG N/S 10" CHERRY.  
279 DEG. 29.46, SET NAIL/TAG S/S 12" OAK.  
346 DEG. 7.97' SET NAIL/TAG W/S 6" CHERRY.

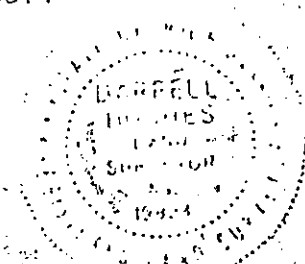

Signed by Darrell Hughes Date October 5, 1995  
Surveyor's Michigan License No. 19834

8-16-95 JED

PUTNAM TOWNSHIP, T1N, R4E

K-9, CORNER COMMON TO SECTIONS 23, 24, 25 AND 26

FIELD: FEBRUARY 1995

FOUND 3/4" IRON PIPE WITH CAP #6998 (ROBERT JAGOW) AT N, E AND W. FENCE INTERSECTION, SET BY JAGOW. WITNESS' MATCH CLOSE TO ACT 74 (SEE PAGE 13), FILED BY JAGOW. SEE PAGE 9. MARGINAL FOR GPS. MEASURES TO L-9: 2598.90' BOSS 77-79, 2598.37' HUGHES 95, BULLOCK 1874 2600.40'. MEASURES TO J-9: 2587.78' DESINE 94, 2587.84' HUGHES 95, 2587.20' GLO 1823.

1823 Corner fist set by Joseph Wampler, U.S. Deputy Surveyor, ... "North between 25 and 26, 80 chains set post". P.7

1874 Miles Bullock surveys Section 25 and divides, shows K-9 to K-10 as (40.14 chains) 2649.24'. Hughes 95 measures 2643.90'. P.8

1972 Robert Jagow sets corner at fence intersection and files Act 74. P.9

1973 Richard Miller performs survey, copies Jagow witness'. P. 9A

1977-1990 Boss surveys in SW 1/4 Sec. 24, copies Jagow witness', P.10-10J

1992 Desine survey uses and shows corner, no witness'. PP. 11

1994 Desine survey, copies Jagow witness'. P. 12

1994 Hughes 95 witness field notes. P. 13