

FILED

9

OCT 16 11 43 AM '95

LAND CORNER RECORDATION CERTIFICATE
Filing Requirement of Act 74, Mich. P.A. 1970

NANCY HAVILAND
REGISTER OF DEEDS
LIVINGSTON COUNTY, MI
48843

corners in

LIVINGSTON Located In: Corner Code M-10
(County)

Public Land Survey T 1N R 4E _____
T _____ R _____
T _____ R _____
T _____ R _____

Property Controlling S _____ T _____ R _____
in Section S _____ T _____ R _____
Miscellaneous S _____ T _____ R _____
Property in Sec. S _____ T _____ R _____

L.S.C.# 497m

Register of Deeds Stamp & File Number

Lot No. _____, Recorded Plat _____
Private Claims _____

	A	B	C	D	E	F	G	H	I	J	K	L	M
2	6		5		4		3		2		1		
3													
4	7		8		9		10		11		12		
5													
6	18		17		16		15		14		13		
7													
8	19		20		21		22		23		24		
9													
10	30		29		28		27		26		25		
11													
12	31		32		33		34		35		36		
13													

DARRELL HUGHES, in a field survey on Oct. 4
JANUARY 24, 19 95,
hereby certify that under requirements of P.A. 74, Michigan P.A. of 1970, the corner points mentioned
lines 1 and 2 above were in conformance with regulations and rules therefore as required in the
current manual of survey instructions of the United States Department of the Interior, Bureau of Land
Management or by a decree of a Court of Law and/or that the corner points mentioned in lines 3, 4 and 5
above were in conformance with the rules of the Michigan Board of Land Surveyors or by a Decree of a
Court of Law; established, re-established, monumented, re-monumented, recovered, found as
expressed below:

NOTE: Not more than 4 corners, all in the same town and range, may be recorded
on this certificate.


Description of original monument and accessories and/or subsequent restoration:
GLO: 1823, Joseph Wampler, Deputy Surveyor
Black Oak 10", North 25 degrees West, 10 links
White Oak 5", South 42 degrees West, 32 links

PUTNAM TWP.
**SURVEY &
REMONUMENTATION**
NOV 27 1995
COMMISSION

Description of corner evidence found and/or method applied in restoring or reestablishing corner:
Corner not found. Corner set on M-9/A-10 line extended to the South
at 1/2 the distance M-9/M-11.

*Additional descriptions and historical information on back of this sheet.

Description of monument for corner and accessories established to perpetuate locating the position of the corner:
M-10, T1N, R4E, PUTNAM, set 1-1/4" X 36" iron pipe, affixed with 2" dia.
brass cap, stamped "Livingston Co. Monumentation Corner, P.S. 19834, and
is accepted as a careful and faithful reestablishment of the position of
the original corner.
237 DEG. 15.71' SET NAIL/TAG SE/S 10" OAK.
133 DEG. 18.45' SET NAIL/TAG NE/S 6" CHERRY.
051 DEG. 21.03' SET NAIL/TAG NW/S 12" MAPLE.
006 DEG. 42.53' SET NAIL/TAG W/S 34" OAK.

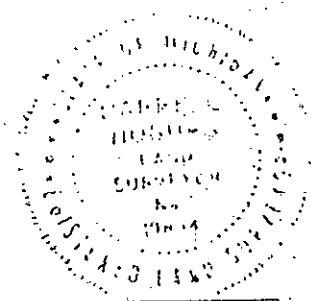

Signed by [Signature] Date October 5, 1995
Surveyor's Michigan License No. 19834

M-10, EAST 1/4 CORNER SECTION 25

FIELD: FEBRUARY 1995

CORNER NOT FOUND. LOCATION IN WOODED AREA WITH NO OCCUPATION TO WEST EVIDENT, EXCEPT FOR N/S FENCE ON TOWNSHIP LINE. CORNER A-10, THE WEST 1/4 CORNER OF SECTION 30, HAMBURG, WAS FOUND AND HAS BEEN IDENTIFIED AND USED BY SEVERAL SURVEYORS. I CONSIDER THIS CORNER LOST AND WILL SET THE CORNER ON THE M-9 / A-10 LINE EXTENDED TO THE SOUTH AT 1/2 DISTANCE M-9 / M-11. THIS CORNER WILL FALL 65.36 FEET SOUTH OF A-10 (A FOUND 3/4" IRON PIPE AT FENCE CORNER, WIRE N,S,E AND NOT 1/2" IRON ROD SET BY CHMP 7' NE. SEE PAGE 17. NOT GOOD FOR GPS, ALL WOODED AREA.

- 1823 Corner first set by Joseph Wampler, U.S. Deputy Surveyor....."North on East boundary Section 25, 40 chains, set 1/4 post". P.7-7a
- 1837 Amos Adams, County Surveyor, surveys in SW 1/4 Sec. 30, Hamburg. 1/4 mile as 1237.50' 1/2 A-10 /A-11. Now 1276.80'. P.8
- 1874 Miles Bullock, County Surveyor, surveys Section 25, Putnam and divides. Shows East 1/2 mile line of Section as 2526.48'. Now 2493.44' 33 feet short. Bullock says he "found center of Section 66 feet to far South with other lines the same". P.9-10.
- 1983 Don Ross surveys in Southeast 1/4 of Section 25. He shows M-11 / M-10 as 2549.07' calc. No witness' for M-10. P.11
- 1985 CHMP shows distance A-11 to A-10 as 2554.61' P.12
- 1986 Boss shows distance A-11 to A-10 as 2554.61' P.15
- 1991 Matt Brady survey (for info only). P.16
- 1995 Hughes sketch for reestablishment of M-10. P.17