


HAMBURG TWP.

T1N , R5E

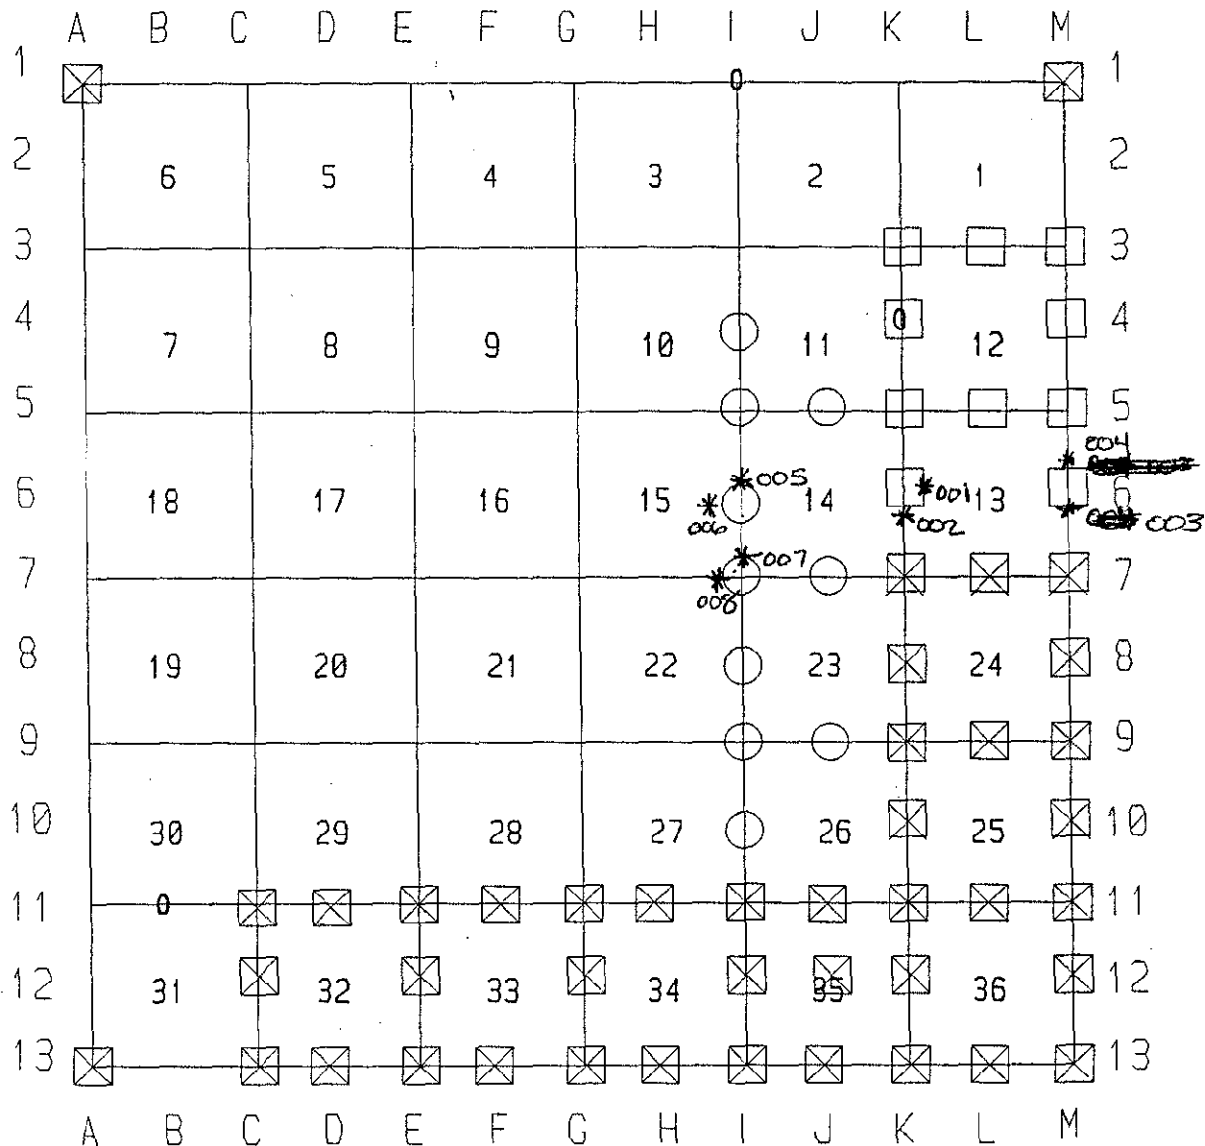

LEGEND

005 LSC 986 Alpha 914
 006 986 915
 007 LSC 987 916
 008 987 917

SURVEY & REMONUMENTATION

FEB 22 1999

SECTION

- ☒ CORNERS COMPLETED TO DATE
- 1996 PROPOSED CORNERS
- 1997 PROPOSED CORNERS
- 0 DOUBLE/PROBLEM CORNERS

PREPARED BY: LIVINGSTON COUNTY EQUALIZATION DEPT. 3/96