MISC. CORNERS

SURVEY &
RE
MAR 1 1 2000
SECTION

HAMBURG TWP.

T1N , R5E

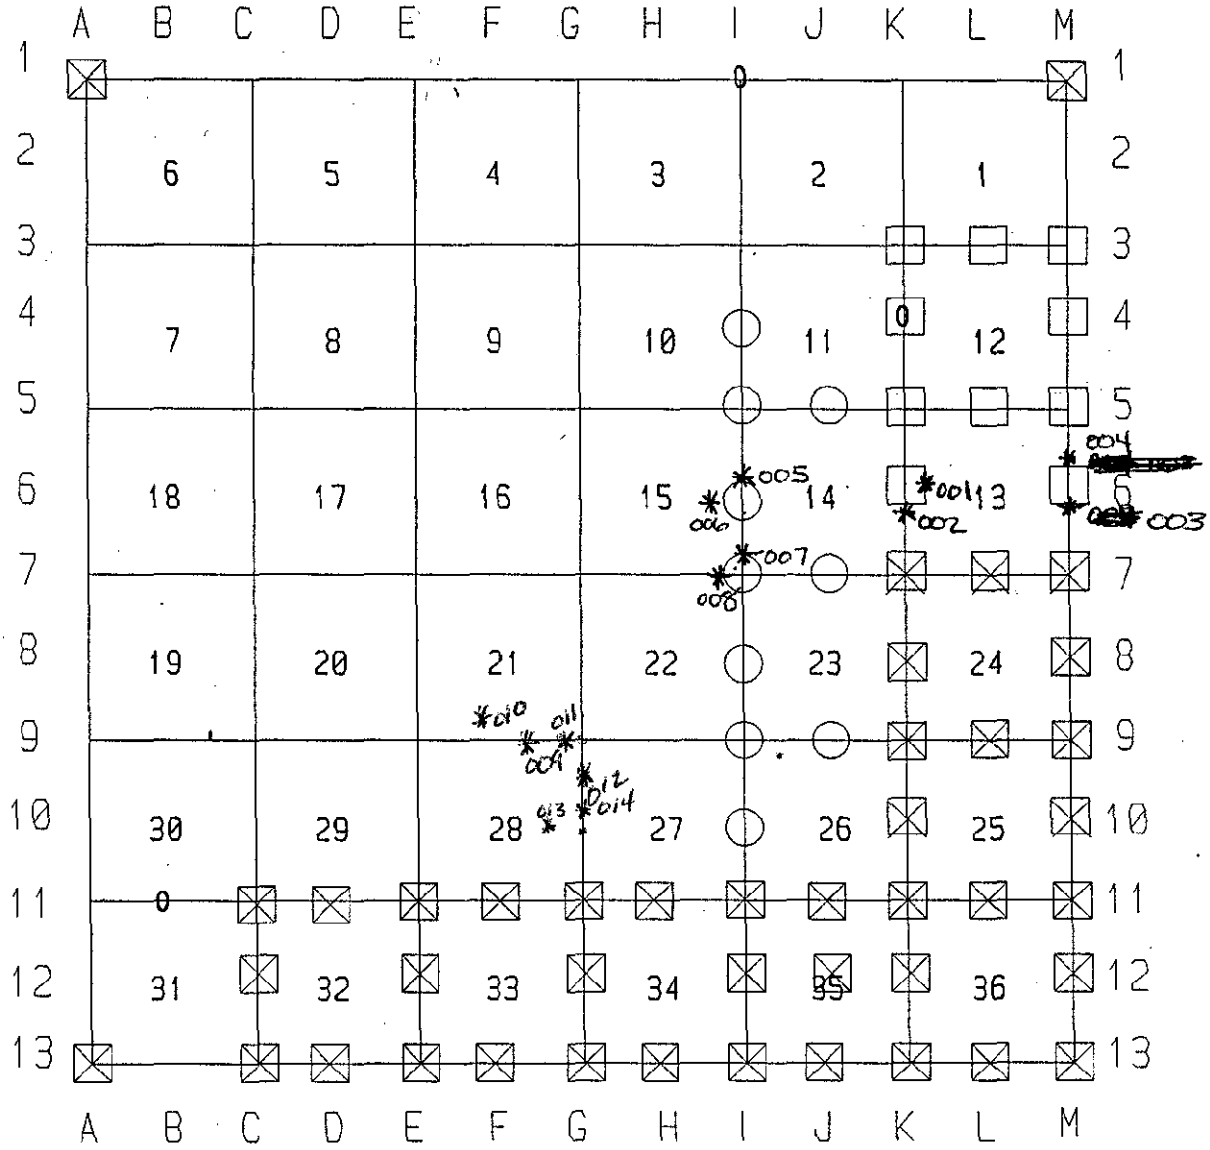

LEGEND

- ☒ CORNERS COMPLETED TO DATE
- □ 1996 PROPOSED CORNERS
- ○ 1997 PROPOSED CORNERS
- 0 DOUBLE/PROBLEM CORNERS

PREPARED BY: LIVINGSTON COUNTY EQUALIZATION DEPT. 3/96