

APR 28 1995

COMMISSION

LAND CORNER RECORDATION CERTIFICATE

Filing Requirement of Act 74, Mich. P.A. 1970

Nov 16 2 07 PM '94

NANCY HAVILAND REGISTER OF DEEDS LIVINGSTON COUNTY, MI 48843

For corners in Livingston (County)

Located In: Corner Code

- 1. Public Land Survey T 1N R 5E C-13
2. Property Controlling In Section S T R
3. Miscellaneous Property In Sec. S T R
4. Lot No. Recorded Plat
5. Private Claims

L.S.C. #373m

Register of Deeds Stamp & File Number

Grid table with columns A-M and rows 2-12. A small circle is marked in row 12, column C.

I, Bryan Boss, in a field survey on 10-27, 1994, do hereby certify that under requirements of P.A. 74, Michigan P.A. of 1970, the corner points mentioned in lines 1 and 2 above were in conformance with regulations and rules therefore as required in the current manual of survey instructions of the United States Department of the Interior, Bureau of Land Management or by a decree of a Court of Law and/or that the corner points mentioned in lines 3, 4 and 5 above were in conformance with the rules of the Michigan Board of Land Surveyors or by a Decree of a Court of Law; established, re-established, monumented, re-monumented, recovered, found as expressed below:

NOTE: Not more than 4 corners, all in the same town and range, may be recorded on this certificate.

A. Description of original monument and accessories and/or subsequent restoration:

- Maple 9" N 76 W 19 1/2 Links
Ash 9" S 75 W 13 Links

Additional data on back.

B. Description of corner evidence found and/or method applied in restoring or reestablishing corner:


Found a 1" inch pipe below surface under a moveable 2" inch pipe encased in concrete.

C. Description of monument for corner and accessories established to perpetuate locating the position of the corner:

Set 1 1/2" x 36" iron pipe with brass cap marked Livingston County Monument corner.

- North 2.50' N&T E/S 6" Walnut
N50°W 17.64' N&T W/S 15" Elm
S50°E 20.76' NE/Corner of Brick garage
S65°W 47.98' NW/Corner of brick family room house #9883

Witnessed by [Signature] Date 10-27-1994
Surveyor's Michigan License No. 29238

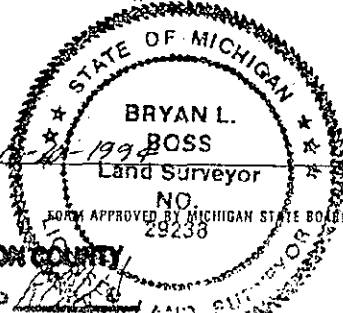

SUMMARY
C-13

SOUTHWEST CORNER, SECTION 32, T1N-R5E HAMBURG TOWNSHIP, LIVINGSTON COUNTY, MICHIGAN.

Found a 1" pipe 0.20 feet below the surface under a moveable 2" pipe encased in concrete. Also found a 1" pipe 10.1 feet East (N.W. Corner, Sec. 5, Webster Township, Atwell-Hicks Survey Page 16).

Baseline originally surveyed by Edward Tiffin in 1815.

Baseline again surveyed by Joseph Wampler in the first quarter of the year 1823.

In 1914, Manley Osgood platted "Brooker's Subdivision" on South shore of Base Lake in Webster Township, Washtenaw County (page 10 this Dossier). In 1917, Manley Osgood of Washtenaw Engineering platted "Brooker's First Addition" and calls for East line of Section 6, Webster Township, to be the East boundary line of said plat and the N. E. Corner of Section 6 as the Point of Beginning (see page 11). In 1920, Grant Dunning surveyed the Southwest 1/4 Section 32 (page 18 this Dossier) and platted "Glenwood on the Lakes" in 1922 (page 12). Note East line of Outlot "A" is also the East line of Section 31, T1N-R5E on "Tamarina", a replat of "Glenwood on the Lakes" by Porter W. O'Donnell on August 31, 1961 (page 13). This location is also verified by Atwell-Hicks, Inc. on 9-27-61 (see page 16).

The undated witness sheet by Atwell-Hicks (page 9) denotes a jog of 6.14 links (4.05 feet) which agrees with G.L.O. map of Webster Township. However, the distance measured in the field is 10.55 feet Atwell-Hicks survey (page 16) and 10.1 feet Boss Engineering witness field notes (page 17 of this Dossier).

Conclusion: The West line of Section 32, T1N-R5E, Hamburg Township is common to the East line of "Tamarina" and "Glenwood on the Lakes". This line extended Southerly across the Huron River does fall 10.55 feet West of Northwest corner of Section 5, Webster Township. We also found a 1" bar 91.0 feet West of corner that agrees with Atwell-Hicks survey on Page 16. We find the 1" pipe to be the Southwest corner of Section 32, as found and recommended accepting the existing 1" pipe..

HSUMC-13



Bryan L. Boss