

MAR 17 2000

FILED

SECTION

LAND CORNER RECORDATION CERTIFICATE 1999 NOV 22 A 11: 08  
Filing Requirement of Act 74, Mich. P.A. 1970

For corners in  
LIVINGSTON  
(County)

Located in: HAMBURG Corner Code #

9

NANCY HAVILAND  
REGISTER OF DEEDS  
LIVINGSTON COUNTY, MI.  
48843

1. Public Land Survey	T	IN	R	SE	E-10
	T		R		
	T		R		
	T		R		
2. Property Controlling In Section	S	T	R		
	S	T	R		
3. Miscellaneous Property in Sec.	S	T	R		
	S	T	R		

LSC# 1117m  
Register of Deeds Stamp and File Number

- 4. Lot No. \_\_\_\_\_, Recorded Plat \_\_\_\_\_
- 5. Private Claims \_\_\_\_\_

I, Bryan L. Boss, in a field survey on 10-19-99  
do hereby certify that under requirements of P.A. 74, Michigan P.A. of 1970, the corner points mentioned in lines 1 and 2 above were in conformance with regulations and rules therefor as required in the current manual of survey instructions of the United States Department of the Interior, Bureau of Land Management or by a decree of a Court of Law and/or that the corner points mentioned in lines 3,4 and 5 above were in conformance with the rules of the Michigan Board of Land Surveyors or by a Decree of a Court of Law; established, re-established, monumented, re-monumented, recovered, found as expressed below.

NOTE: Not more than 4 corners, all in the same town and range, may be recorded on this certificate.

A	B	C	D	E	F	G	H	I	J	K	L	M
2	6	5	4	3	2	1						
3												
4	7	8	9	10	11	12						
5												
6	18	17	16	15	14	13						
7												
8	19	20	21	22	23	24						
9												
10	30	29	28	27	26	25						
11												
12	31	32	33	34	35	36						
13												

A. Description of original monument and accessories and/or subsequent restoration:

- SET POST
- 14" WHITE OAK N.18°E 11LINKS
- 12" WHITE OAK S.47°W 19 LINKS


B. Description of corner evidence found and/or method applied in restoring or reestablishing corner:

- FOUND 1/2" IRON PIPE WITH CAP #14762

C. Description of monument for corner and accessories established to perpetuate locating the position of the corner:

- SET BRASS CAP STAMPED "LIVINGSTON COUNTY REMONUMENTATION CORNER" ON TOP OF FOUND PIPE (WITH CAP #14762)
- N75°W 17.70' SET REMON NAIL & TAG S/S 10" CHERRY DUE SOUTH 36.49' SET REMON N/T E/S 24" MAPLE
- DUE EAST 3.45' SET REMON NAIL & TAG N/S 26" MAPLE
- DUE NORTH 23.77' SET REMON NAIL & TAG W/S 18" TWIN MAPLE

P.A. 345 1890, APPROVED BY LIVINGSTON COUNTY  
PEER GROUP ON 8.4.99 CO. REP JED

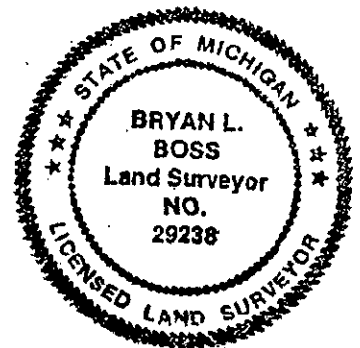

Signed by [Signature] Date NOV. 11, 1999  
Surveyor's Michigan License No. 29238