

SURVEY & REMONUMENTATION

Nov 16 2 07 PM '94

APR 28 1995 LAND CORNER RECORDATION CERTIFICATE
Filing Requirement of Act 74, Mich. P.A. 1970

NANCY HAVILAND
REGISTER OF DEEDS
LIVINGSTON COUNTY, MI
48843

For corners in
Livingston
(County)

COMMISSION
Located In:

Corner Code #/

1. Public Land Survey	T	<u>1N</u>	R	<u>5E</u>	<u>E-12</u>
	T		R		
	T		R		
	T		R		
2. Property Controlling In Section	S		T	R	
	S		T	R	
3. Miscellaneous Property in Sec.	S		T	R	
	S		T	R	

L.S.C.#377m

Register of Deeds Stamp & File Number

4. Lot No. _____, Recorded Plat _____
5. Private Claims _____

	A	B	C	D	E	F	G	H	I	J	K	L	M
2	6	5	4	3	2	1							
3													
4	7	8	9	10	11	12							
5													
6	18	17	16	15	14	13							
7													
8	19	20	21	22	23	24							
9													
10	30	29	28	27	26	25							
11													
12	31	32	33	34	35	36							
13													

I, Bryan Boss, in a field survey on 11-3, 19 94, do hereby certify that under requirements of P.A. 74, Michigan P.A. of 1970, the corner points mentioned in lines 1 and 2 above were in conformance with regulations and rules therefore as required in the current manual of survey instructions of the United States Department of the Interior, Bureau of Land Management or by a decree of a Court of Law and/or that the corner points mentioned in lines 3, 4 and 5 above were in conformance with the rules of the Michigan Board of Land Surveyors or by a Decree of a Court of Law; established, re-established, monumented, re-monumented, recovered, found as expressed below:

NOTE: Not more than 4 corners, all in the same town and range, may be recorded on this certificate.

A. Description of original monument and accessories and/or subsequent restoration:

- Black Oak 13" S 44 E 22 Links
- Black Oak 6" N 7 E 17 Links
- Black Oak 30" Westerly 26.5 feet
- White Oak 18" Southwest 52 feet
- Hickory 10" Northwest 72 feet


Additional data on back.

B. Description of corner evidence found and/or method applied in restoring or reestablishing corner:

Found hooked iron rod in concrete 2 feet South of South edge Dunlavy Lane. Witnesses from six surveyors describe same location.

C. Description of monument for corner and accessories established to perpetuate locating the position of the corner:

Set 1 1/4" x 36" iron pipe with brass cap marked Livingston County Monument Corner.
S70°E 12.91' N&T N/S 8"Oak
S15°W 10.07' N&T E/S 6"Cherry
N80°W 71.75' N&T S/S 12"Hickory
N50°E 137.78 N&T SE/S 14"Poplar

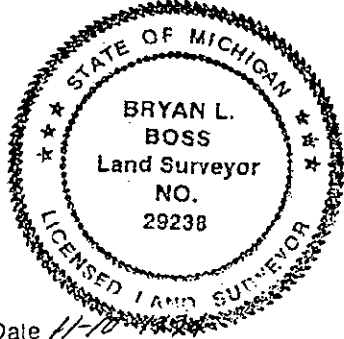

signed by Bryan L. Boss
Surveyor's Michigan License No. 29238

Date 11-10-94

TIN-R5E

E-12

Page 1

SUMMARY
E-12

EAST 1/4 CORNER, SECTION 32, T1N-R5E HAMBURG TOWNSHIP, LIVINGSTON COUNTY, MICHIGAN.

Found hooked iron rod in concrete at surface of ground 2 feet South of South edge Dunlavy Lane. Open field to the North and medium to light woods Southerly. Overhanging branches will make this corner difficult for G.P.S.


Measured to witnesses found. Found 2 of 4 Robert Jagow (page 11) Act 74 witnesses and they checked. Found 2 of 3 Atwell-Hicks witnesses (page 12) and they checked. Found 3 of 4 Atwell-Hicks witnesses (page 13); they checked. Found 2 of 3 Washtenaw Engineering witnesses (pages 14, 21, 22, 27) and they checked. Found 2 of 4 Boss Engineering witnesses (pages 15, 23, 24); they checked.

Found 2 of 4 Patrick Benton witnesses (pages 16, 17, 18, 19, 20) and they checked. Found 1 of 3 Timothy Tietsema witnesses and it was 0.25' short.

Found 2 of 4 witnesses from September 21, 1939 Clay Gordon field notes (page 28) and they checked.

Conclusion: Numerous surveys have utilized this corner since 1939. Witnesses from six independent firms and/or surveyors describe the same location and hooked iron in concrete. We, therefore, recommend acceptance of corner as found to be the East 1/4 corner of Section 32, Hamburg Township.

HSUME-12

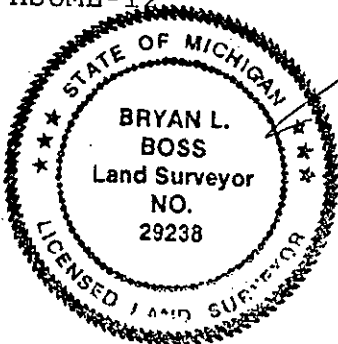

A handwritten signature in black ink, appearing to read "Bryan L. Boss", written over the right side of the professional seal.