

SURVEY & REMONUMENTATION

FILED

APR 28 1995 LAND CORNER RECORDATION CERTIFICATE

Nov 16 2 07 PM '94

Filing Requirement of Act 74, Mich. P.A. 1970

HANGY HAVILAND
REGISTER OF DEEDS
LIVINGSTON COUNTY, MI
48843

For corners in Livingston **COMMISSION**

(County)	Located In:	Corner Code #
1. Public Land Survey	T <u>1N</u> R <u>5E</u>	<u>E-13</u>
	T _____ R _____	_____
	T _____ R _____	_____
	T _____ R _____	_____
2. Property Controlling In Section	S _____ T _____ R _____	_____
	S _____ T _____ R _____	_____
3. Miscellaneous Property in Sec.	S _____ T _____ R _____	_____
	S _____ T _____ R _____	_____

L.S.C.#378m

Register of Deeds Stamp & File Number

4. Lot No. _____, Recorded Plat _____
5. Private Claims _____

	A	B	C	D	E	F	G	H	I	J	K	L	M
2	5	5	4	3	2	1							
3													
4	7	8	9	10	11	12							
5													
6	15	17	16	15	14	13							
7													
8	19	20	21	22	23	24							
9													
10	30	29	28	27	26	25							
11													
12	31	32	33	34	35	36							
13													

I, Bryan Boss, in a field survey on 11-3, 19 94, do hereby certify that under requirements of P.A. 74, Michigan P.A. of 1970, the corner points mentioned in lines 1 and 2 above were in conformance with regulations and rules therefore as required in the current manual of survey instructions of the United States Department of the Interior, Bureau of Land Management or by a decree of a Court of Law and/or that the corner points mentioned in lines 3, 4 and 5 above were in conformance with the rules of the Michigan Board of Land Surveyors or by a Decree of a Court of Law; established, re-established, monumented, re-monumented, recovered, found as expressed below:

NOTE: Not more than 4 corners, all in the same town and range, may be recorded on this certificate.

A. Description of original monument and accessories and/or subsequent restoration:

Black Oak 20" N 21 W 30 Links
White Oak 17" N 75 W 81 Links

Additional data on back.


B. Description of corner evidence found and/or method applied in restoring or reestablishing corner:

Found 3/4" inch x 4 feet pipe in open field with unidentifiable cap 2 feet below ground surface. Pipe set by Atwell-Hicks in 1972.

Description of monument for corner and accessories established to perpetuate locating the position of the corner:

Set 1 1/4" x 36" iron pipe with brass cap marked Livingston County Monument corner. Also set orange fiberglass post for guard purposes.

N40°E 161.83' N&T Top Center of Railroad Post
S60°E 158.22' N&T N/S 18" Oak
South 134.25' N&T /S 18" Poplar
S80°W 145.12' Northeast corner of steel hangar building

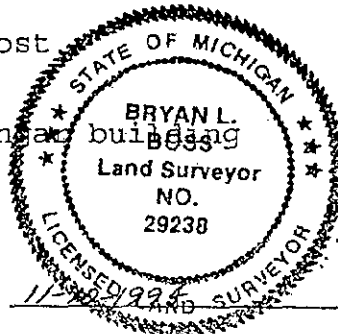

Signed by Bryan L. Boss
Surveyor's Michigan License No. 29238

Date 11-15-94

SUMMARY
E-13

SOUTHEAST CORNER, SECTION 32, T1N-R5E HAMBURG TOWNSHIP, LIVINGSTON COUNTY, MICHIGAN.

Found 3/4" x 4.0' pipe in open field with unidentifiable cap 2 feet below ground surface.

The baseline was originally surveyed by Edward Tiffin in 1815. Township lines and baseline again surveyed in 1823 by Joseph Wampler.


Measured to witnesses found. Found 3 of 4 Atwell-Hicks witnesses (page 12) and they checked. 12" Oak (NE Corner woods) is now 18" Oak. 10" Twin Oak is now 14" twin oak; 10" poplar is now 18" poplar. Found 3 of 4 Patrick Benton Witnesses (pages 12, 14, 15, 16, 18 and Act 74 on page 17). They all checked. Found 3 of 4 Boss Engineering witnesses (pages 19, 21, 24) and they checked.

The undated witness sheet by Atwell-Hicks (page 10) denotes a jog of 7.00 links (4.62 feet) which agrees with G.L.O. map of Webster Township. However, the distance measured in the field is 140.75 feet Boss Engineering Survey (pages 20, 22, 23, 25, 26 of this Dossier).

All Surveys from 3-27-73 (Patrick Benton page 13) to 5-9-94 (Boss Engineering page 24) refer to pipe set by Atwell-Hicks on May 2, 1972.

Conclusion: We find the 3/4" x 4 feet pipe set by Atwell-Hicks in 1972 to be the Southeast corner of Section 32, Hamburg Township.

HSUME-13

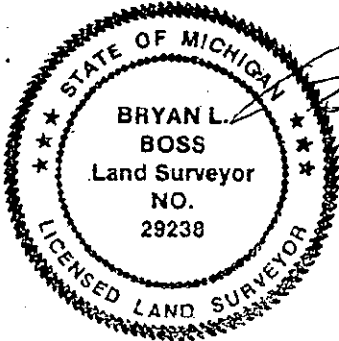

Bryan L. Boss