

SURVEY & REMONUMENTATION

FILED

Nov 16 2 07 PM '94

APR 28 1995

LAND CORNER RECORDATION CERTIFICATE

Filing Requirement of Act 74, Mich. P.A. 1970

NANCY HAVILAND
REGISTER OF DEEDS
LIVINGSTON COUNTY, MI
48843

For corners in
Livingston
(County)

COMMISSION

Located in:

Corner Code ##

- | | | | |
|---------------------------------------|-------------------------|-------|-------|
| 1. Public Land Survey | T <u>1N</u> R <u>5E</u> | _____ | F-13 |
| | T _____ R _____ | _____ | _____ |
| | T _____ R _____ | _____ | _____ |
| | T _____ R _____ | _____ | _____ |
| 2. Property Controlling
In Section | S _____ T _____ R _____ | _____ | _____ |
| | S _____ T _____ R _____ | _____ | _____ |
| 3. Miscellaneous
Property in Sec. | S _____ T _____ R _____ | _____ | _____ |
| | S _____ T _____ R _____ | _____ | _____ |

L.S.C. #379m

Register of Deeds Stamp & File Number

4. Lot No. _____, Recorded Plat _____
5. Private Claims _____

	A	B	C	D	E	F	G	H	I	J	K	L	M
2	6	5	4	3	2	1							
3													
4	7	8	9	10	11	12							
5													
6	18	17	16	15	14	13							
7													
8	19	20	21	22	23	24							
9													
10	30	29	28	27	26	25							
11													
12	31	32	33	34	35	36							
13													

I, Bryan Boss, in a field survey on 11-2, 19 94, do hereby certify that under requirements of P.A. 74, Michigan P.A. of 1970, the corner points mentioned in lines 1 and 2 above were in conformance with regulations and rules therefore as required in the current manual of survey instructions of the United States Department of the Interior, Bureau of Land Management or by a decree of a Court of Law and/or that the corner points mentioned in lines 3, 4 and 5 above were in conformance with the rules of the Michigan Board of Land Surveyors or by a Decree of a Court of Law; established, re-established, monumented, re-monumented, recovered, found as expressed below:

NOTE: Not more than 4 corners, all in the same town and range, may be recorded on this certificate.

A. Description of original monument and accessories and/or subsequent restoration:

- | | | | |
|-----------|----|---------|----------|
| Black Oak | 9" | N 24½ E | 56 Links |
| White Oak | 4" | S 18 E | 36 Links |

Additional data on back.


B. Description of corner evidence found and/or method applied in restoring or reestablishing corner:

Found capped iron Oscar Boss #13594 at base of corner post. Fence occupation North, East and West.

C. Description of monument for corner and accessories established to perpetuate locating the position of the corner:

Set 1½" x 36" iron pipe with brass cap marked Livingston County Monument corner.

- West 9.11' N&T S/S Railroad Post
- N5°E 13.35' N&T E/S 24" Oak
- N88°E 116.15' N&T 30" Cherry
- North 0.13' Fence Corner Post

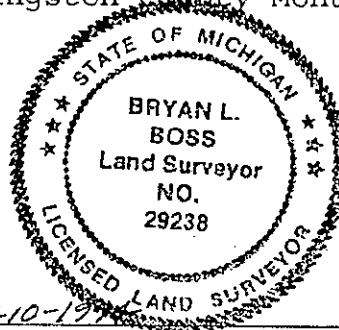

Signed by Bryan L. Boss

Date 11-10-1994

Surveyor's Michigan License No. 29238

TIN-R5E

F-13

Page 1

SUMMARY

F-13

SOUTH 1/4 CORNER, SECTION 33, T1N-R5E HAMBURG TOWNSHIP, LIVINGSTON COUNTY, MICHIGAN.

Found Oscar Boss capped iron at base of corner post. Fence occupation North, East and West of corner post. Accessible for G.P.S.

The baseline was surveyed by Edward Tiffin in 1815. Township lines and baseline again surveyed in 1823 by Joseph Wampler.

On November 5, 1972, Patrick Benton field notes (page 19) show evidence of Southwest 1/4 of Section 33 traverse. Distance from South 1/4 corner of Section 33 to the center of said Section is 2640.25 feet (Patrick Benton Survey page 10 of this Dossier); 2640.25 feet Boss Engineering survey page 15. In 1972 Patrick Benton calls South 1/4 at fence corner (page 19). On 7-30-74 Patrick Benton again calls South 1/4 corner of Section 33 a found corner post (no other witnesses) on page 10. Boss Engineering survey on (page 12) also calls South 1/4 corner a found corner post in 1977. On 8-22-91 Boss Engineering witnesses (page 16) call for found capped Boss Iron at South edge 8" x 10" wood post. 3 of 4 witnesses were found on 5-9-94 and they checked. North 1/4 corner of section 4, Webster Township (not found).

Surveys beginning with Patrick Benton in 1973 until 8-19-80 have utilized a found corner post. On 5-2-77 Boss Engineering set and witnessed South 1/4 Corner of Section 33 (see pages 24, 25).

Conclusion: We recommend accepting corner as set by Boss Engineering on 5-2-77.

HSUMF-13

